pd. 9/25

IREDELL COUNTY HEALTH DEPARTMENT

STATESVILLE 704-878-5305 MOORESVILLE 704-664-5281

IMPROVEMENT PERMIT / AUTHORIZATION TO CONSTRUCT / OPERATION PERMIT / EXISTING SYSTEM INSPECTION

PERMIT# 093883 PIN# ~~4702-85-3081 (pt)~~ 4702-84-7733 DATE Feb 23, 01

OWNER OR CONTRACTOR Roger Otterbach // Eufola Rd Properties PHONE: Business 878-8654 Home

ADDRESS 109 Desiree Dr. Statesville N.C. 28677

LOCATION From Traitman OR NHN RD TL Celeste Eufola TR Eufola ~ 1/4 mile TL Desiree Dr 8th lot on left

SUBDIVISION Shenandoah BLOCK / SECTION LOT 8 LOT AREA ~5.04 Ac SITE CLASS. PS DESIGN FLOW 360 gpd L.T.A.R. .25 x 3

Septic Tank: 1000 Gallons; STB 1012 Date 07/05/02

Pump Tank: Gallons; PT Date

Pump Make: Model Serial No.

Nitrification Field: No Fields 1 Square Feet 1080 Linear Feet 360

No Lines 4 Trench Width 36" Max Trench Bottom Depth ~30" Gravel Depth NA

☑ New System ☐ Repair System Type: I, II, III, IV, V, VI

System Description: Gravity Innovative - 25% Red.

Repair System Description: LPP Innovative

Maintenance Agreement Required: ☐ Yes ☑ No

☐ House/Mod. Home No. Bedrooms 3

☑ Mobile Home DW No. Bathrooms 2

☐ Business No. Employees

☐ Other

☐ Slab ☑ Crawl Space ☐ Basement w/plumbing ☐ Basement wo/plumbing


Water Supply: ☐ Individual ☑ Public ☐ Community

Comments:/Conditions:

Comments:/Conditions: 3 Br, 2 BA Floor Plan Approved 12/27/02

INITIAL SITE SKETCH

1" = 50'

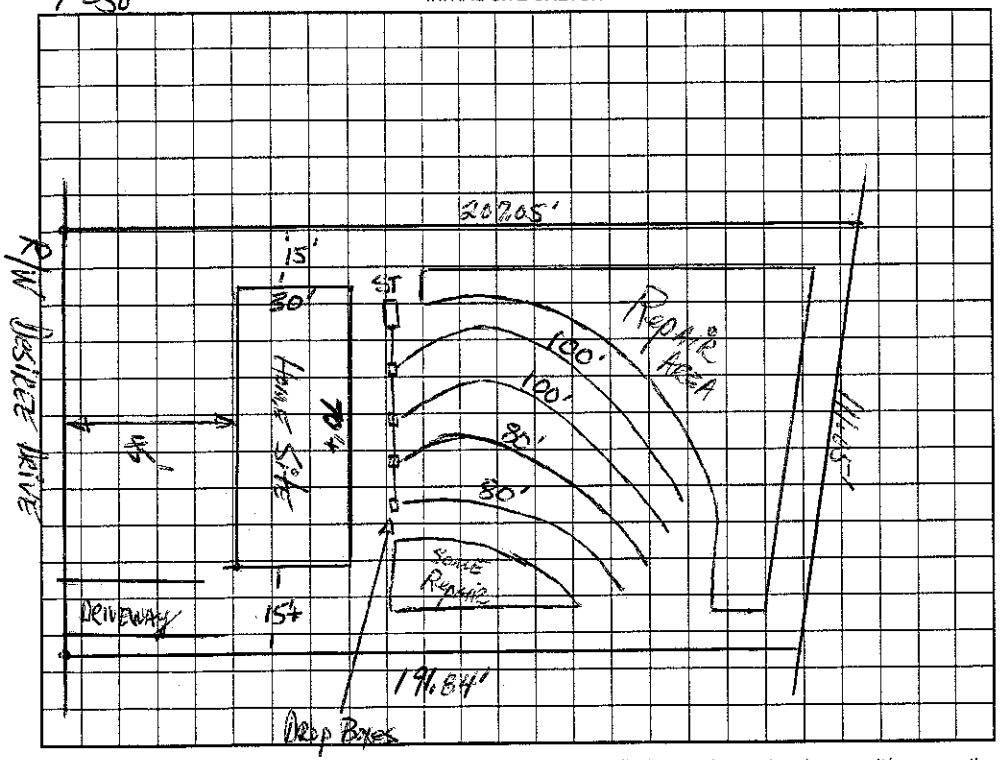

AS BUILT SKETCH

- SEPTIC TANK INSTALLED USING TUFF-TIGHT FILTER & TANK MARKER.

* SYSTEM INSTALLED AS SHOWN IN INITIAL SITE SKETCH.

Permit can be suspended or revoked if any false information is supplied toward securing the permit/any unauthorized changes are made to the site/any unauthorized changes are made in the installation of the system. Improvement Permit with plat valid without expiration. Improvement Permit with site plan valid for sixty months. Authorization to Construct is valid for a period equal to that of Improvement Permit – not to exceed sixty months.

Signed: Roger J. Otterbach date 4-24-01 Installed by: CRAIG THOMPSON

Improvement Permit by: date 2-23-01 Operation Permit by: Patrick Mitchell date 01/15/03

Authorization to Construct by: date 12/27/02 Existing System Inspection by: date

HEALTH DEPT. COPY: WHITE OWNER COPY (FINAL): YELLOW OWNER COPY (INITIAL): PINK