IREDELL COUNTY HEALTH DEPARTMENT

STATESVILLE 704-878-5305 MOORESVILLE 704-664-5281

IMPROVEMENT PERMIT / CERTIFICATE OF COMPLETION / OPERATION PERMIT / EXISTING SYSTEM INSPECTION

JM 25 2-11-98

PROPERTY DESCRIPTION NO. 69245 DATE 9-20-97 TAX MAP NO. 4702943542

OWNER OR CONTRACTOR Sunwest Builders PHONE: Business 872 0921 Home

ADDRESS PO Box 58217 Sta TL Watershed: ☑ Yes ☐ No

LOCATION 70 W Exfola TR Pounders TR Span 36 Rt WSIV PA

SUBDIVISION Reaves BLOCK / SECTION LOT 24 LOT AREA .65 Acres SITE CLASS. PS DESIGN FLOW 360 L.T.A.R. .3

Septic Tank: 1000 Gallons; STB 101 E Date 9-24-97

Pump Tank: Gallons; PT Date 12-9-97

Pump Make: Model Serial No.

Nitrification Field: No Fields 1 Square Feet 900 Linear Feet 300

No Lines 3 Trench Width 36" Max Trench Bottom Depth 36" Gravel Depth N/A

☐ New System ☐ Repair System Type: I, II, III, IV, V, VI

System Description: Gravity Chambers or HDS

Repair System Description:

Maintenance Agreement Required: ☐ Yes ☑ No

☐ House/Mod. Home ☑ Mobile Home ☐ Business ☐ Other

No. Bedrooms 3 No. Bathrooms 2 No. Employees

☐ Slab ☑ Crawl Space ☐ Basement w/plumbing ☐ Basement wo/plumbing


Water Supply: ☑ Individual ☐ Community ☐ Public

Comments:

Comments:

* Note: Tank & Driveway Switched

INITIAL SITE SKETCH

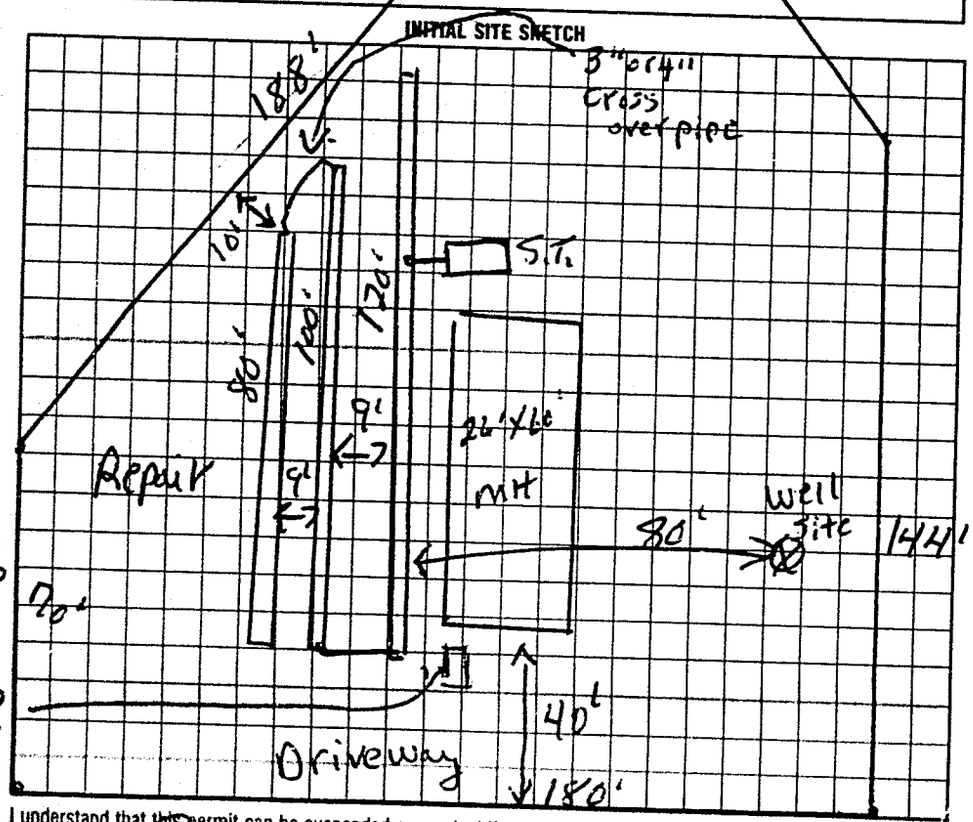

AS BUILT SKETCH

* Installed as shown

I understand that this permit can be suspended or revoked if any false information is supplied toward securing the permit/any unauthorized changes are made to the site/any unauthorized changes are made in the installation of the system. Improvement Permit is valid for 60 months from date of issuance.

Signed:

Improvement Permit by: P.C. moore date 9-20-97

Authorization to Existing System Inspection by: P.C. moore date 9-20-97

to cont.

Installed by: Tommy Frye

Certificate of Completion by: date

Operation Permit by: Mary C Ott RS date 4-7-98

HEALTH DEPT. COPY: WHITE INSPECTION COPY (FINAL): GREEN OWNER COPY (FINAL): YELLOW INSPECTION COPY (INITIAL): PINK OWNER COPY (INITIAL): GOLD

Authorization to cont Expires 60 mos from issue