IREDELL COUNTY HEALTH DEPARTMENT

STATESVILLE 704-878-5305 MOORESVILLE 704-664-5281

IMPROVEMENT PERMIT / AUTHORIZATION TO CONSTRUCT / OPERATION PERMIT / EXISTING SYSTEM INSPECTION

PERMIT# 80113 PIN# 4702851060

OWNER OR CONTRACTOR MARK WALLACE PHONE: Business _____ Home 7045286210 DATE April 5, 99

ADDRESS 349 WAGGOFF ST TROUTMAN NC

LOCATION GT 8 Lansdowne off Eufola Rd

SUBDIVISION Lansdowne BLOCK / SECTION _____ LOT 8 LOT AREA 1.03 Ac. SITE CLASS. RS DESIGN FLOW 360 L.T.A.R. 63

Septic Tank: 1500 Gallons: STB _____ Date _____

Pump Tank: _____ Gallons: PT _____ Date _____

Pump Make: _____ Model _____ Serial No. _____

Nitrification Field: No Fields 1 Square Feet 1200 Linear Feet 400

No Lines 4 Trench Width 36" Max Trench Bottom Depth 36" Gravel Depth 12"

☒ New System ☐ Repair System Type: I II III IV V VI

System Description: Conv. Gravity

Repair System Description: Rmp/50% Reduction

Maintenance Agreement Required: ☐ Yes ☒ No

☐ Slab ☒ Crawl Space ☐ Basement w/plumbing ☐ Basement wo/plumbing

☐ House/Mod. Home No. Bedrooms 3

☒ Mobile Home No. Bathrooms 2

☐ Business No. Employees _____


☐ Other _____

Water Supply: ☐ Individual ☒ Public ☐ Community


Comments:/Conditions: Lines on Contour
Repair only Require 50% Reduction / Rmp System
Call before Installing 12.8 2030

Comments./Conditions

INITIAL SITE SKETCH

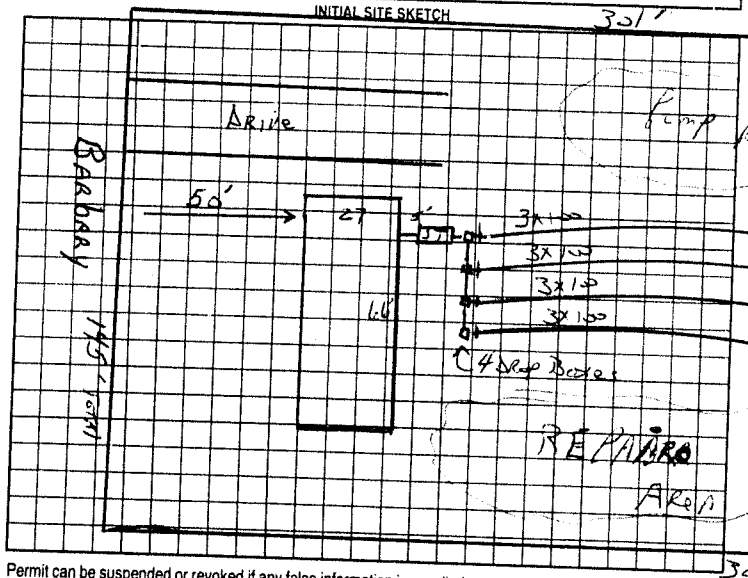

AS BUILT SKETCH

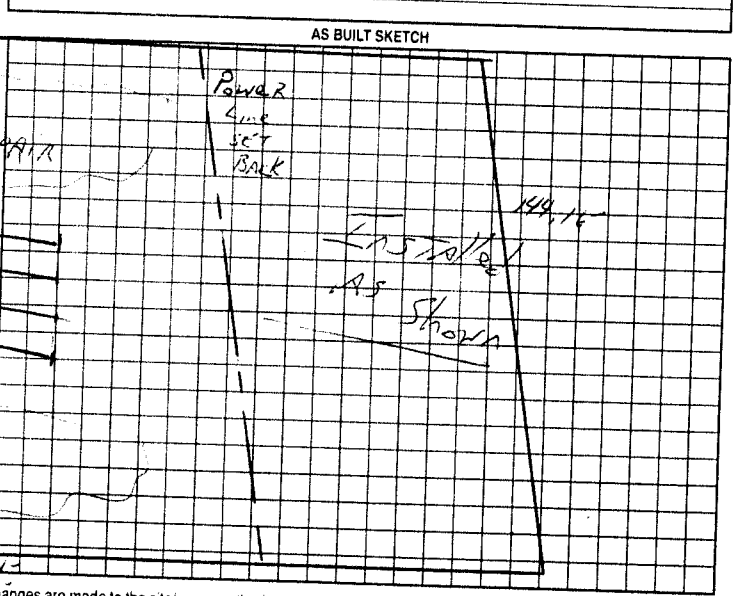

Permit can be suspended or revoked if any false information is supplied toward securing the permit/any unauthorized changes are made to the site/any unauthorized changes are made in the installation of the system. Improvement Permit with plat valid without expiration. Improvement Permit with site plan valid for sixty months. Authorization to Construct is valid for a period equal to that of Improvement Permit – not to exceed sixty months.

Signed: Lindsay Fields

Improvement Permit by: C Potter date 4-5-99

Authorization to Construct by: C Potter date 4-5-99

Installed by: A1 Backhoe

Operation Permit by: C Potter date 5/1/99

Existing System Inspection by: _____ date _____

HEALTH DEPT. COPY: WHITE OWNER COPY (FINAL): YELLOW OWNER COPY (INITIAL): PINK