IREDELL COUNTY HEALTH DEPARTMENT

STATESVILLE 704-878-5305 MOORESVILLE 704-664-5281

IMPROVEMENT PERMIT / AUTHORIZATION TO CONSTRUCT / OPERATION PERMIT / EXISTING SYSTEM INSPECTION

PERMIT# 81297 PIN# 4702833355 DATE May

OWNER OR CONTRACTOR Herman Hunter PHONE: Business Home 704 394 6301

ADDRESS 3700 Avalon Ave Charlotte NC

LOCATION Lt #7 on Left on Barbary Dr off Eufola Rd

SUBDIVISION Lansdowne BLOCK / SECTION LOT 7 LOT AREA .95 Ac SITE CLASS. F5 DESIGN FLOW 360 L.T.A.R. .3

Septic Tank: 1000 Gallons; STB 1012 Date 4-17-99
Pump Tank: Gallons; PT Date
Pump Make: Model Serial No.
Nitrification Field: No Fields 1 Square Feet 1200 Linear Feet 400
No Lines 5@80 Trench Width 36" Max Trench Bottom Depth 36 Gravel Depth 12"

☒ New System ☐ Repair System Type: I (II) III, IV, V, VI
System Description: Conv. Gravity
Repair System Description: Gravity 25% Reduction Area
Maintenance Agreement Required: ☐ Yes ☒ No
☐ Slab ☒ Crawl Space ☐ Basement w/plumbing ☐ Basement wo/plumbing


☐ House/Mod. Home No. Bedrooms 3
☒ Mobile Home MH Pre No. Bathrooms 2
☐ Business No. Employees
☐ Other

Water Supply: ☐ Individual ☒ Public ☐ Community

Comments/Conditions: Call 928-2050 Jo Potter Before Installing
Keep within The 75ft Setback Duke Power


Comments/Conditions

INITIAL SITE SKETCH

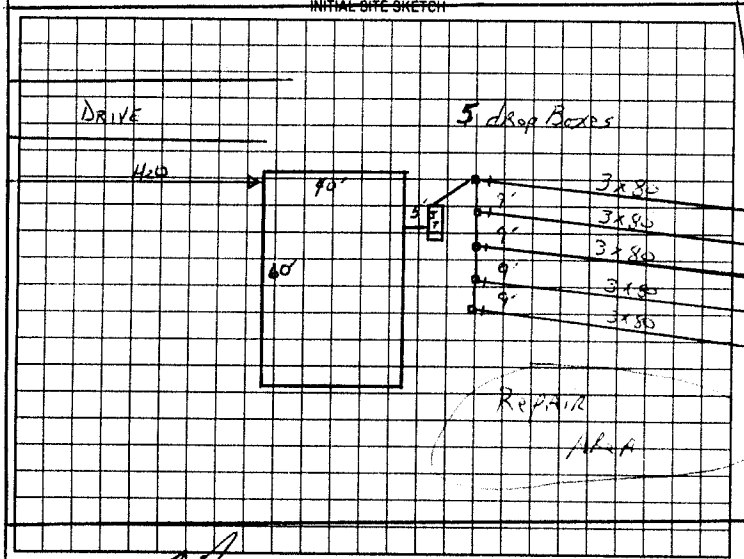

Duke Power Setback

AS BUILT SKETCH

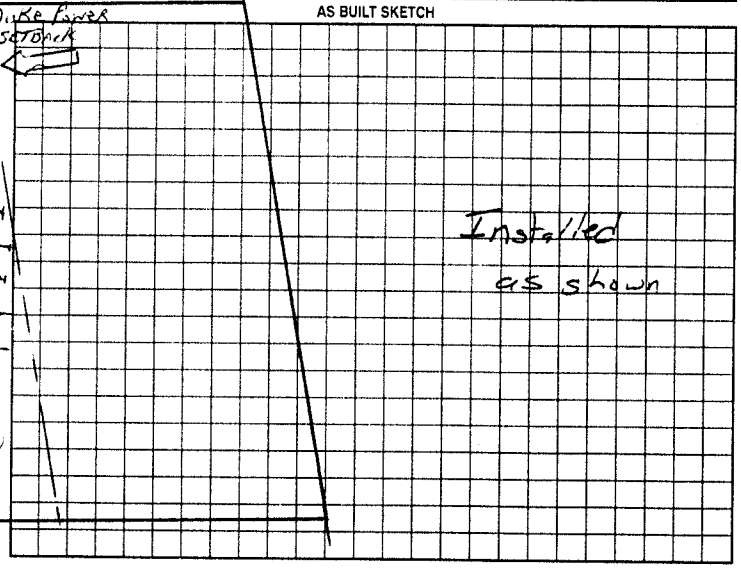

Permit can be suspended or revoked if any false information is supplied toward securing the permit/any unauthorized changes are made to the site/any unauthorized changes are made in the installation of the system. Improvement Permit with plat valid without expiration. Improvement Permit with site plan valid for sixty months. Authorization to Construct is valid for a period equal to that of Improvement Permit – not to exceed sixty months.

Signed: date 5-24-99

Improvement Permit by: date 5-24-99

Authorization to Construct by: date 5-24-99

Installed by: A-1 Backhoe

Operation Permit by: M+C Ozmers date 6-1-99

Existing System Inspection by: date

HEALTH DEPT. COPY: WHITE OWNER COPY (FINAL): YELLOW OWNER COPY (INITIAL): PINK