Gordan Hollern   Permit # 178325
151 Barbary Dr

IREDELL COUNTY HEALTH DEPARTMENT

IMPROVEMENT PERMIT / AUTHORIZATION TO CONSTRUCT / OPERATION PERMIT / EXISTING SYSTEM INSPECTION

STATESVILLE 704-878-5305   MOORESVILLE 704-664-5281

PERMIT# 117933   PIN# 4702-85-1259

OWNER OR CONTRACTOR KINGS FORREST INC

ADDRESS 5551 MONROE RD CHARLOTTE NC 28212   PHONE: Business 704-532-6625   Home ____   DATE 2-12-04

LOCATION I-40 WEST, (L) OMR (R) LEWIS FERRY (L) EUFOLA (R) BARBARY LOT # 6 ON LEFT

SUBDIVISION LANDSDOWNE   BLOCK / SECTION ____   LOT 6   LOT AREA 0.88AC   SITE CLASS PS   DESIGN FLOW 480   L.T.A.R. .3

Septic Tank: 1000 Gallons; STB 1012 Date 11-15-04

Pump Tank: ____ Gallons; PT ____ Date ____

Pump Make: ____ Model ____ Serial No. ____

Nitrification Field: No Fields 1   Square Feet ED=1600'   Linear Feet 400'

No Lines 4X100'   Trench Width 36"   Max Trench Bottom Depth 36"   Gravel Depth N/A

☒ New System ☐ Repair   System Type: I, II, (III), IV, V, VI

System Description: GRAV 25% REDUCT

Repair System Description: LP PANEL

Maintenance Agreement Required: ☐ Yes ☒ No

☐ Slab ☒ Crawl Space ☐ Basement w/plumbing ☐ Basement wo/plumbing

☐ House/Mod. Home ☒ Mobile Home ☐ Business ☐ Other

No. Bedrooms 4   No. Bathrooms 2   No. Employees ____


Water Supply: ☐ Individual ☒ Public ☐ Community

Comments:/Conditions: (1) INSTALL LINES ON CONTOURS (2) MAINTAIN SETBACKS


Comments:/Conditions: INSTALLED 3 100' LINES ELIMINATING THE LAST LINE

(X) NEEDS (1) $50.00 REDRAW ✓ (2) HOUSE PLANS, NEED TO SIGN (3) CONTRACTORS PERMISSION ✓

INITIAL SITE SKETCH

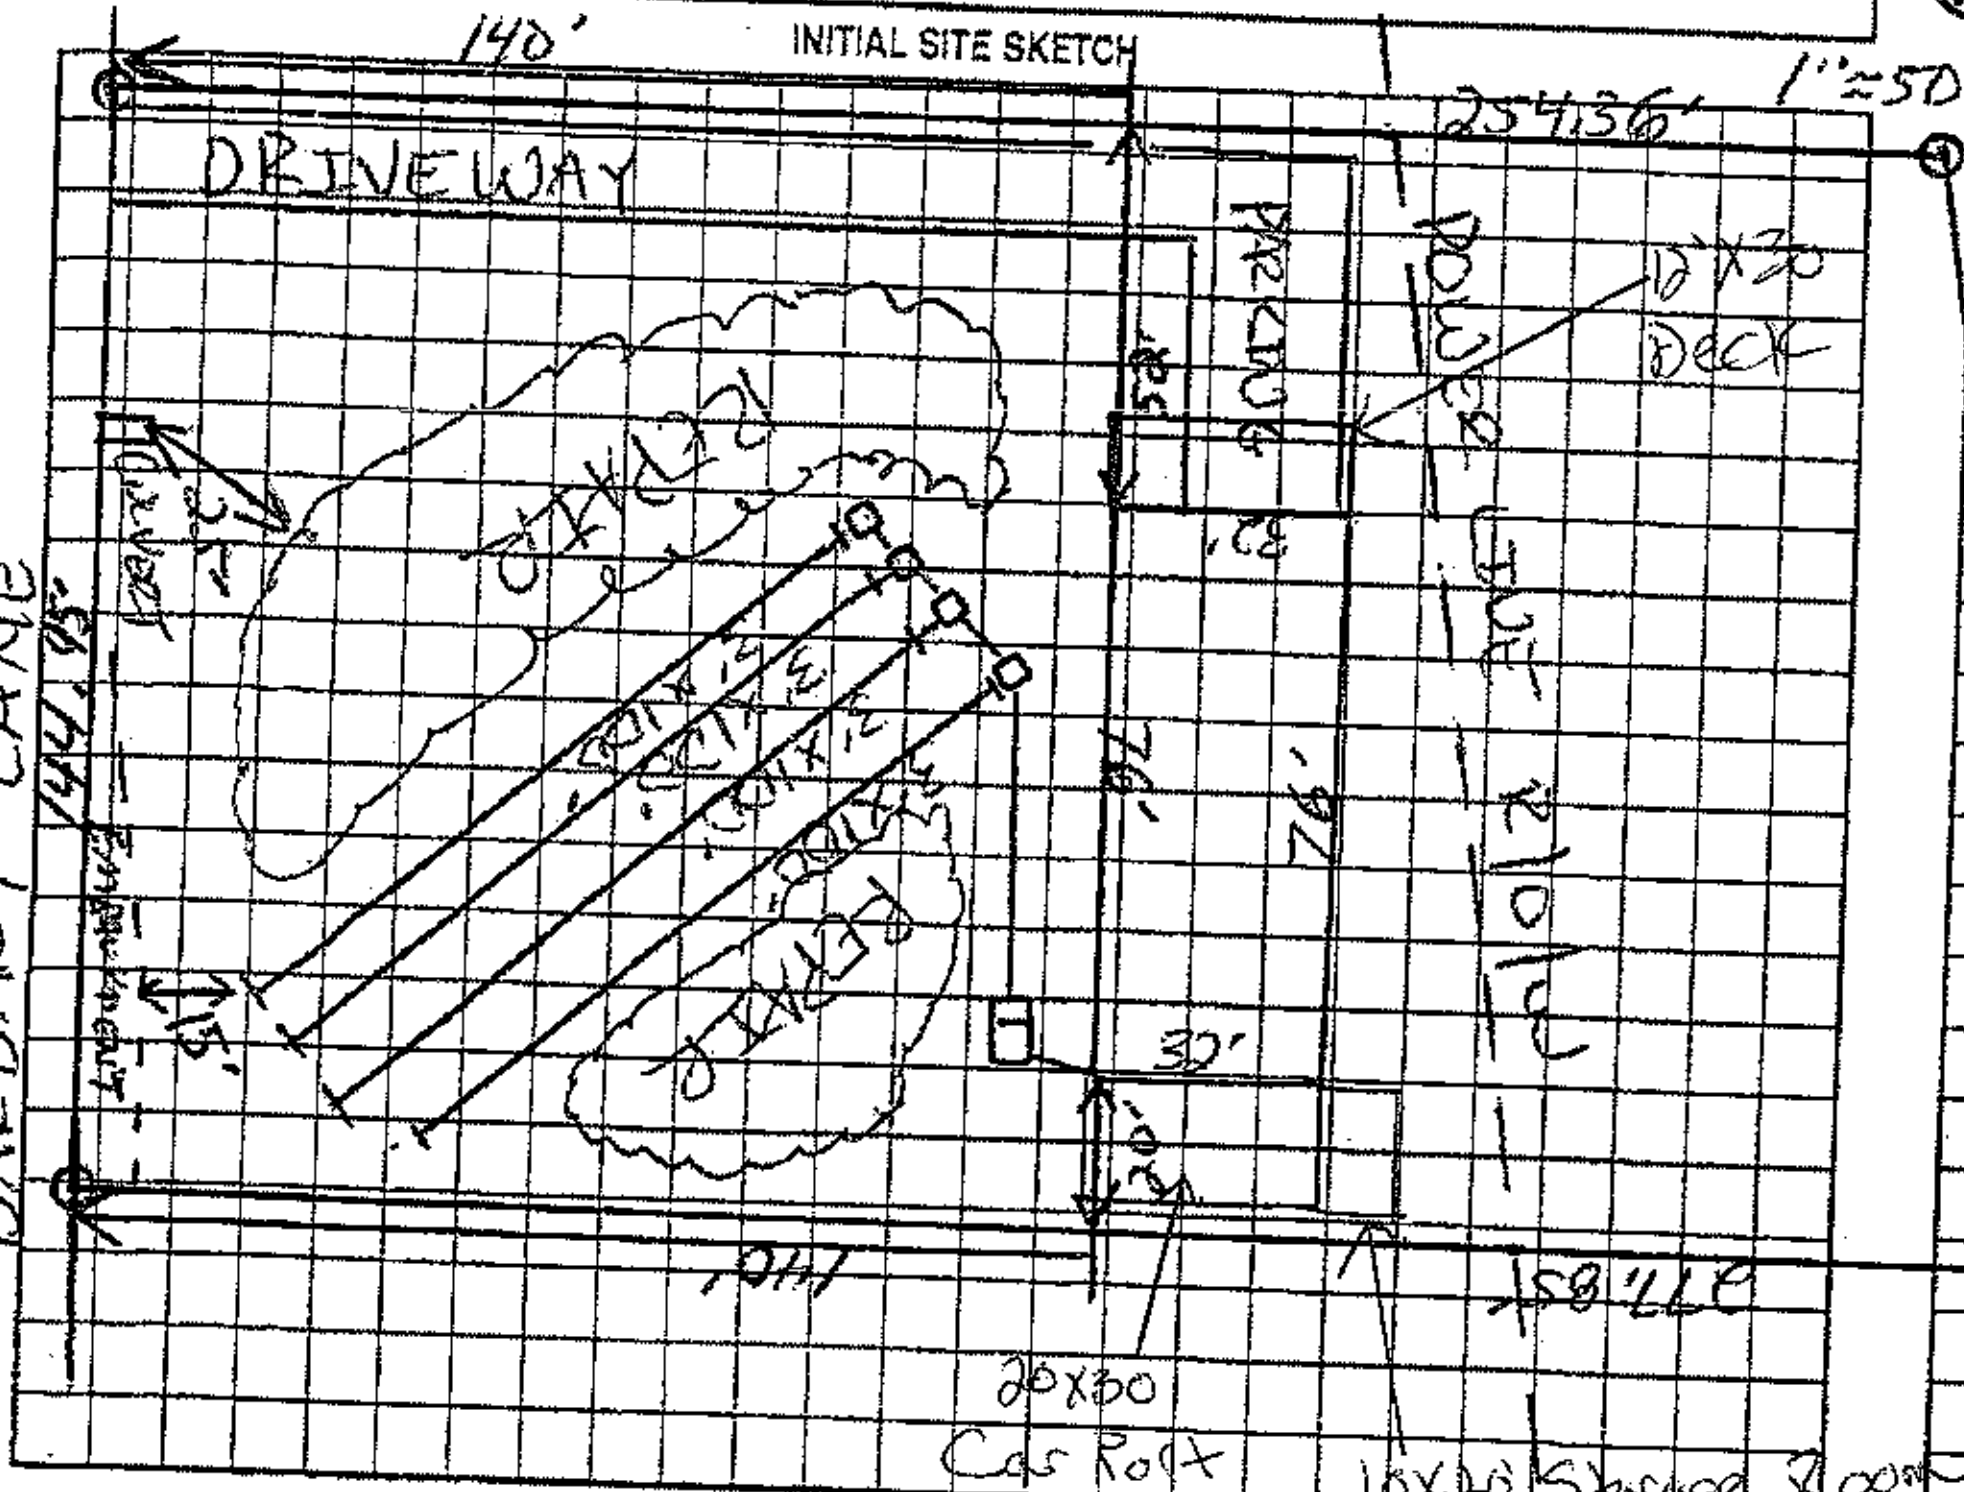

AS BUILT SKETCH

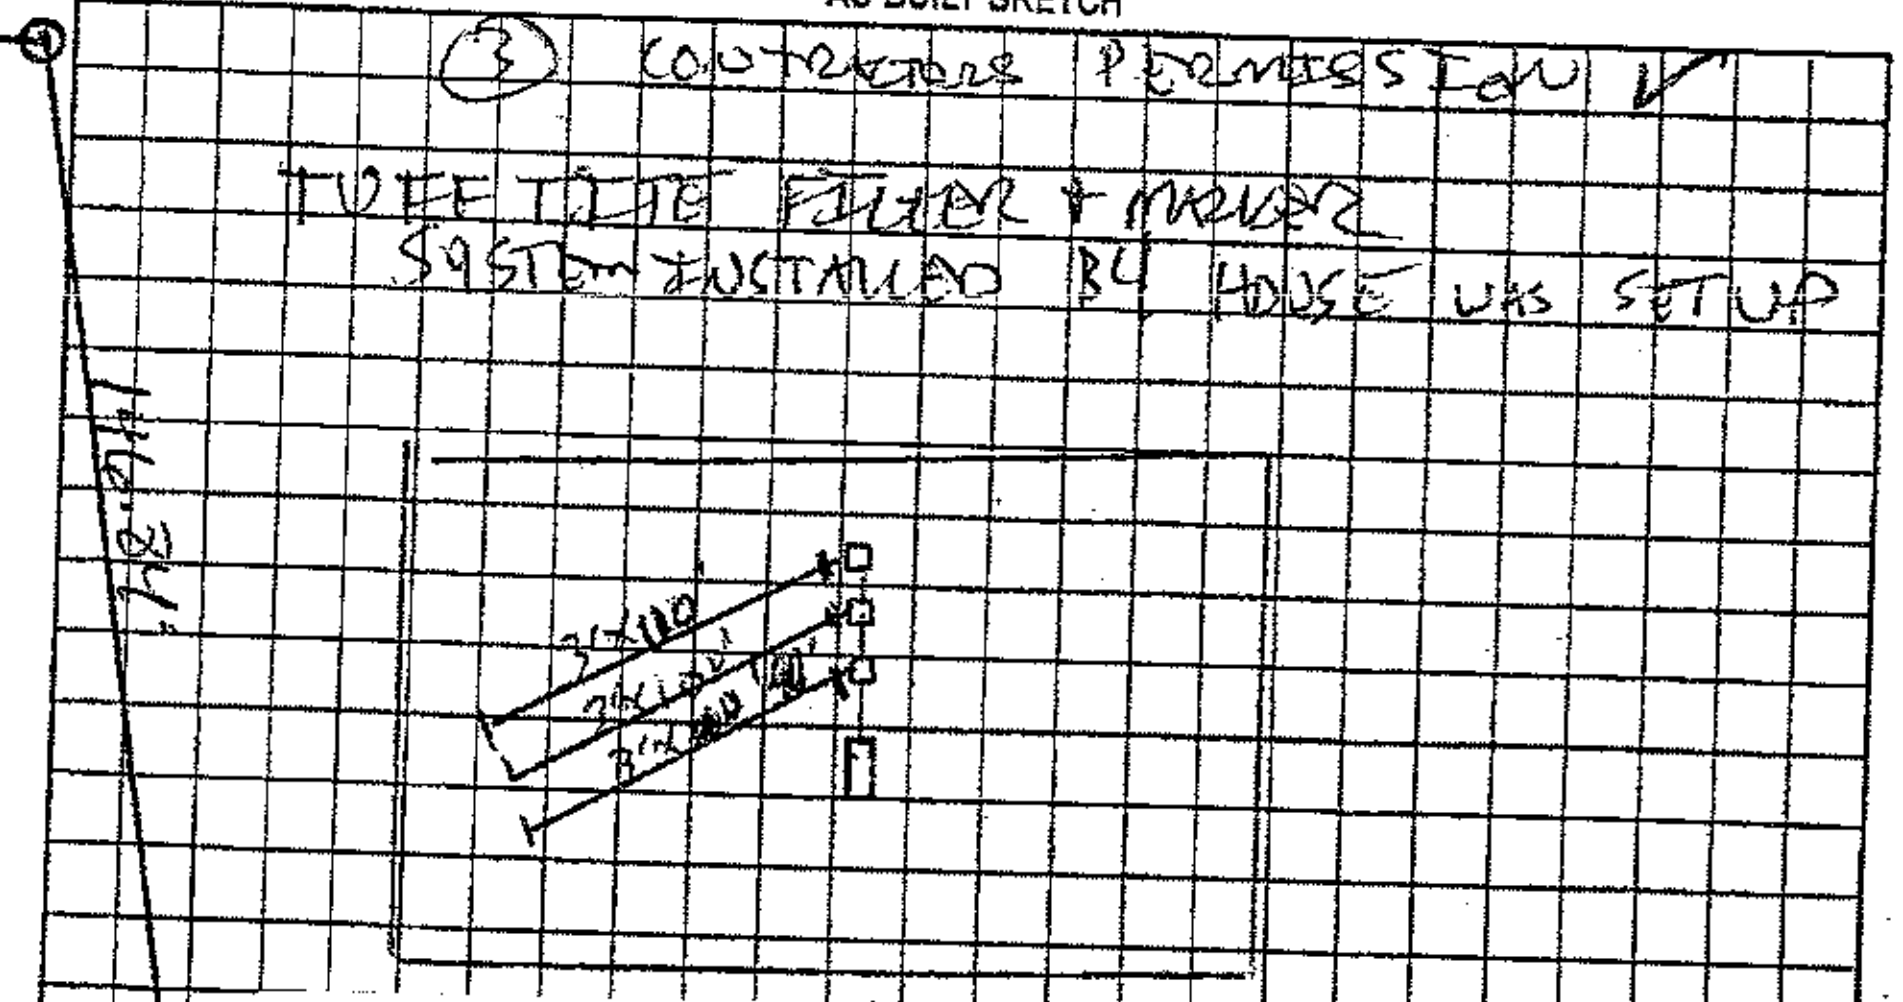

Location of the proposed Deck, Car Port, Storage room **addition does not appear to impact the existing on-site septic system.**NOTE:**

[signature] **REHS**

Date: 4-23-13

ICHD-Environmental Health Division

Permit can be suspended or revoked if any false information is supplied toward securing the permit/any unauthorized changes are made to the site/any unauthorized changes are made in the installation of the system. Improvement Permit with plat valid without expiration. Improvement Permit with site plan valid for sixty months. Authorization to Construct is valid for a period equal to that of Improvement Permit – not to exceed sixty months.

Signed: [signature] date ____

Improvement Permit by: [signature] RS date 2-12-04

Authorization to Construct by: [signature] RS date 2-12-04

Installed by: A-1 BACKHOE

Operation Permit by: [signature] RS date 1-6-05

Existing System Inspection by: ____ date ____

HEALTH DEPT. COPY: WHITE   OWNER COPY (FINAL): YELLOW   OWNER COPY (INITIAL): PINK