pd 9/25

IREDELL COUNTY HEALTH DEPARTMENT

STATESVILLE 704-878-5305 MOORESVILLE 704-664-5281

IMPROVEMENT PERMIT / AUTHORIZATION TO CONSTRUCT / OPERATION PERMIT / EXISTING SYSTEM INSPECTION

PERMIT# 093891 PIN# 4702 85 5081 (pt) DATE Feb 23, 01

OWNER OR CONTRACTOR Roger Hendrix / Eutola Rd. Properties PHONE: Business 876-8654 Home

ADDRESS 109 Desiree Drive Statesville NC 28677

LOCATION From Trautman Old US 70 TL Celeste-Eutola TR Eutola 1/4 mile TL Desiree Dr. on Right

SUBDIVISION Shenandoah BLOCK / SECTION LOT 13 LOT AREA .739Ac SITE CLASS B DESIGN FLOW 360gpd L.T.A.R. .625-e3

Septic Tank: 1000 Gallons: STB 312 Date 7-24-01
Pump Tank: 1000 Gallons: PT 280 Date 9-10-01
Pump Make: Hydromatic Model SR50 Serial No
Nitrification Field: No Fields 1 Square Feet Linear Feet 440
No Lines 4@110' Trench Width 36" Max Trench Bottom Depth 30" Gravel Depth 12"

☐ New System ☐ Repair System Type: I. II. III. IV. V. VI
System Description: pm - conventional
Repair System Description: pm - Innovative - 25% Red
Maintenance Agreement Required: ☐ Yes ☒ No

☒ House/Mod. Home ☐ Mobile Home ☐ Business ☐ Other
No. Bedrooms 3 No. Bathrooms 2 No. Employees
☐ Slab ☐ Crawl Space ☐ Basement w/plumbing ☐ Basement wo/plumbing


Water Supply: ☐ Individual ☒ Public ☐ Community

Comments/Conditions: Do Not cut

Comments/Conditions – Zabel Filter Installed 11/29/01 WJ
– Septic Tank Marker Installed
– Lines + Tank okay – WJ
– Pressure Check + PM, okay + Electrical – okay 12/6/01 WJ

1"=50'

INITIAL SITE SKETCH

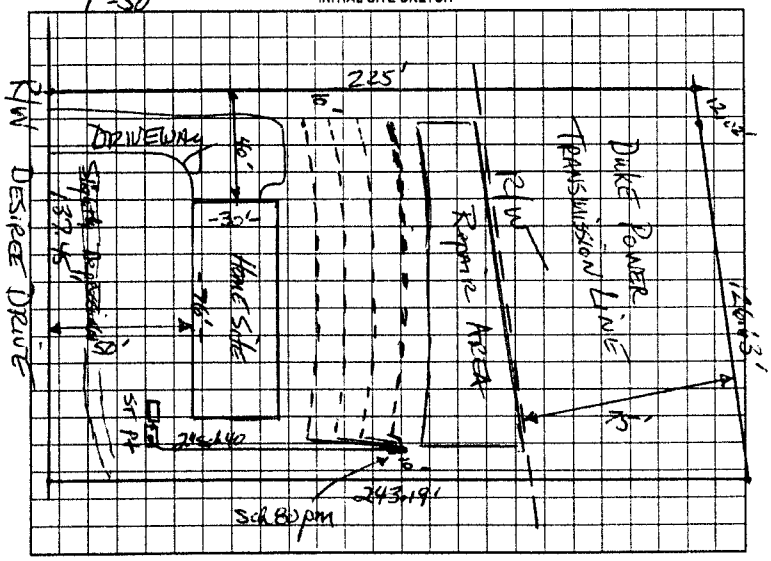

AS BUILT SKETCH Alarm ok 12/21/01 WJ

Installed as Shown per Initial Site Sketch

Permit can be suspended or revoked if any false information is supplied toward securing the permit/any unauthorized changes are made to the site/any unauthorized changes are made in the installation of the system. Improvement Permit with plat valid without expiration. Improvement Permit with site plan valid for sixty months. Authorization to Construct is valid for a period equal to that of Improvement Permit – not to exceed sixty months.

Signed: Roger L. Hendrix date 4-24-01
Improvement Permit by: Mark A. Amos, RS date 2-23-01
Authorization to Construct by: William O. Johnson date 12-10-01

Installed by: Craig Thompson
Operation Permit by: William O. Johnson date 12/21/01
Existing System Inspection by: date

HEALTH DEPT COPY: WHITE OWNER COPY (FINAL): YELLOW OWNER COPY (INITIAL): PINK