pd. #125

IREDELL COUNTY HEALTH DEPARTMENT

STATESVILLE 704-878-5305 MOORESVILLE 704-664-5281

IMPROVEMENT PERMIT / AUTHORIZATION TO CONSTRUCT / OPERATION PERMIT / EXISTING SYSTEM INSPECTION

PERMIT# 043892 PIN# ~~4702-85-5081 (pt.)~~ 4702-85-4143 DATE Feb 23, 01

OWNER OR CONTRACTOR Roger Otterbach / Eufola Rd Properties PHONE: Business 878-8654 ~~Home~~ MIKE JENKINS 704-883-8247 704-682-0922

ADDRESS 109 Desiree Dr. Statesville N.C. 28677

LOCATION From Ingram Old Mtn Rd. TL Celeste-Eufola Rd TR Eufola ~ 1/4 mile TL Desiree Dr. on Right

SUBDIVISION Shenandoah BLOCK / SECTION ____ LOT 14 LOT AREA ±.715 AC SITE CLASS. 5 DESIGN FLOW 360gpd L.T.A.R. .3

Septic Tank: 1000 Gallons; STB 825 Date 12/03/02
Pump Tank: 1000 Gallons; PT 802 Date 12/03/02
Pump Make: ZOELLER Model N-98 Serial No. ½ HP
Nitrification Field: No Fields 1 Square Feet 900 Linear Feet 300
No Lines 3 Trench Width 36" Max Trench Bottom Depth 36" Gravel Depth N/A

☑ New System ☐ Repair System Type: I, II, (III), IV, V, VI
System Description: 9M INNOVATIVE -25% Red.
Repair System Description: LP INNOVATIVE 50% Red.
Maintenance Agreement Required: ☐ Yes ☑ No

☑ House/Mod. Home ☑ Mobile Home ☐ Business ☐ Other
No. Bedrooms 3 No. Bathrooms 2 No. Employees ____
☐ Slab ☑ Crawl Space ☐ Basement w/plumbing ☐ Basement wo/plumbing


Water Supply: ☐ Individual ☑ Public ☐ Community

Comments:/Conditions:


Comments:/Conditions: - SEPTIC TANK INSTALLED USING POLY - LOC-FILTER + TANK MARKER.

1"=50'

INITIAL SITE SKETCH

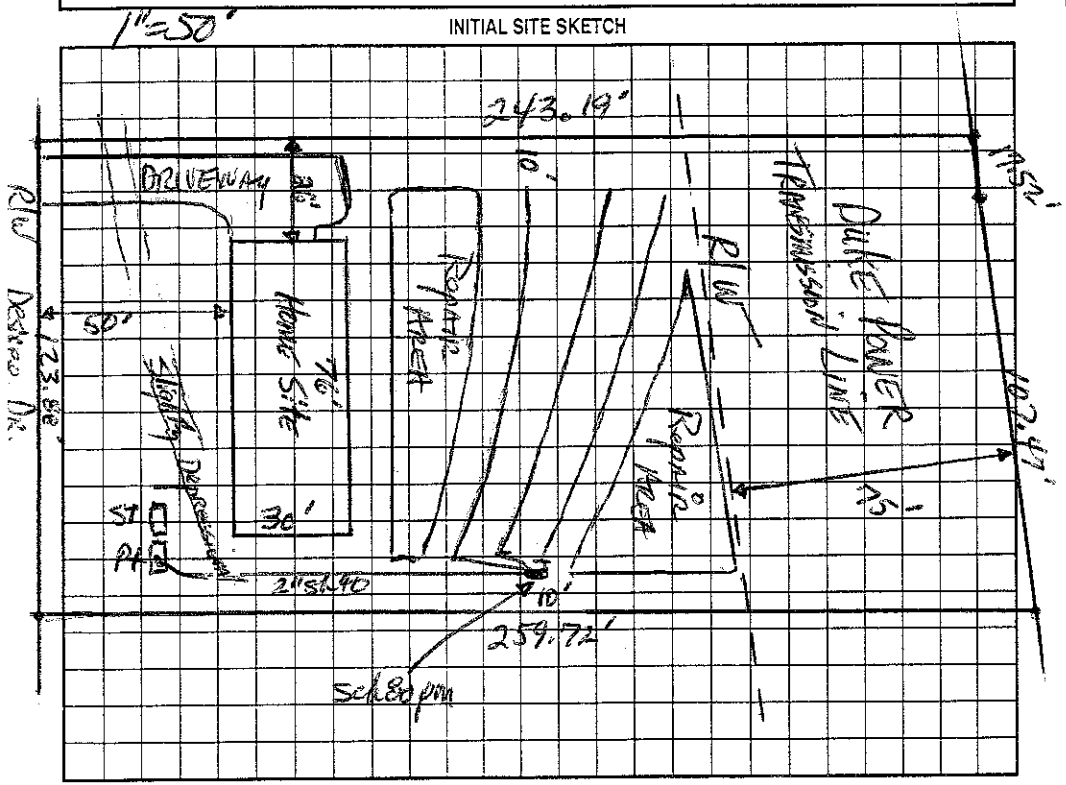

AS BUILT SKETCH

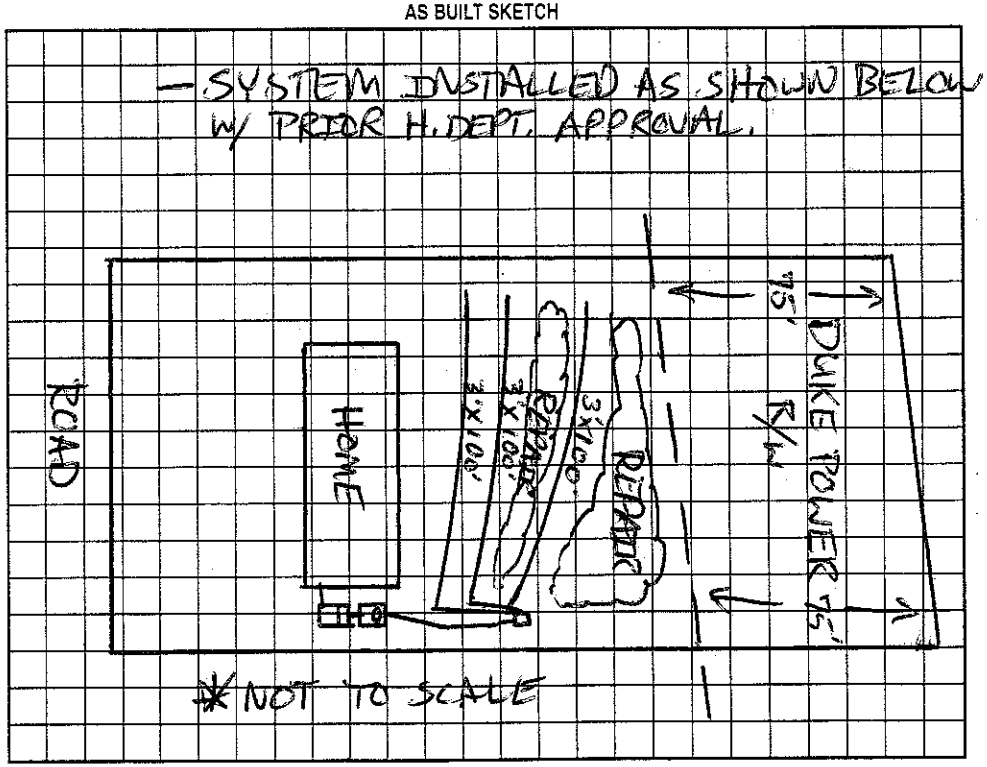

Permit can be suspended or revoked if any false information is supplied toward securing the permit/any unauthorized changes are made to the site/any unauthorized changes are made in the installation of the system. Improvement Permit with plat valid without expiration. Improvement Permit with site plan valid for sixty months. Authorization to Construct is valid for a period equal to that of Improvement Permit – not to exceed sixty months.

Signed: Roger L. Otterbach date 4-24-01
Improvement Permit by: David L. Hargrove, RS date 2-23-01
Authorization to Construct by: William G. Johnson date 11/12/02

Installed by: BOB'S BACKHOE 02-13-03
Operation Permit by: Patrick Mitchell date 02/26/03
Existing System Inspection by: ____ date ____

HEALTH DEPT. COPY: WHITE OWNER COPY (FINAL): YELLOW OWNER COPY (INITIAL): PINK