IREDELL COUNTY HEALTH DEPARTMENT

STATESVILLE 704-878-5305 MOORESVILLE 704-664-5281

IMPROVEMENT PERMIT / AUTHORIZATION TO CONSTRUCT / OPERATION PERMIT / EXISTING SYSTEM INSPECTION

PERMIT# 92659 PIN# 4702 85 5081 DATE 10/27/00

OWNER OR CONTRACTOR Oakwood Homes PHONE: Business 528-4516 Home

ADDRESS 1042 Charlotte Hwy Troutman NC 28166

LOCATION Buffalo Shoals, R/En Rola, L Desiree on Rt

SUBDIVISION Shenandoah BLOCK / SECTION — LOT 15 LOT AREA 0.70 AC SITE CLASS PS DESIGN FLOW 480 L.T.A.R. 0.3

Septic Tank: 1000 Gallons: STB 312 Date 2-29-00
Pump Tank: Gallons: PT Date
Pump Make: Model Serial No.
Nitrification Field: No Fields 1 Square Feet 1200 Linear Feet 400
No Lines 5 Trench Width 36" Max Trench Bottom Depth 36" Gravel Depth —

☒ New System ☐ Repair System Type: I, II, (III), IV, V, VI
System Description: Gravity 25% Red.
Repair System Description: Gravity/Pump 25% Red.
Maintenance Agreement Required: ☐ Yes ☒ No

☐ House/Mod. Home No. Bedrooms 4
☒ Mobile Home No. Bathrooms 2
☐ Business No. Employees
☐ Other


☐ Slab ☒ Crawl Space ☐ Basement w/plumbing ☐ Basement wo/plumbing

Water Supply: ☐ Individual ☒ Public ☐ Community


Comments:/Conditions:

Comments:/Conditions: - marks Installed, Tuff-Tite Filter Installed, 40-10 ft Secure of HEDS installed

INITIAL SITE SKETCH

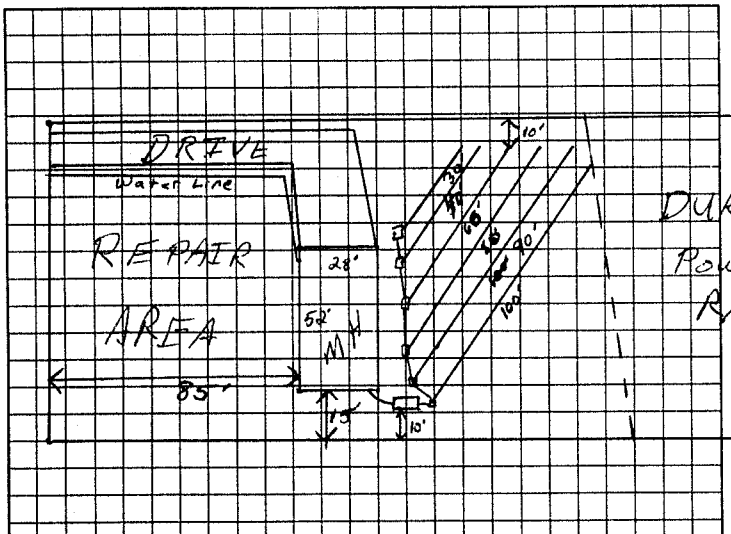

AS BUILT SKETCH

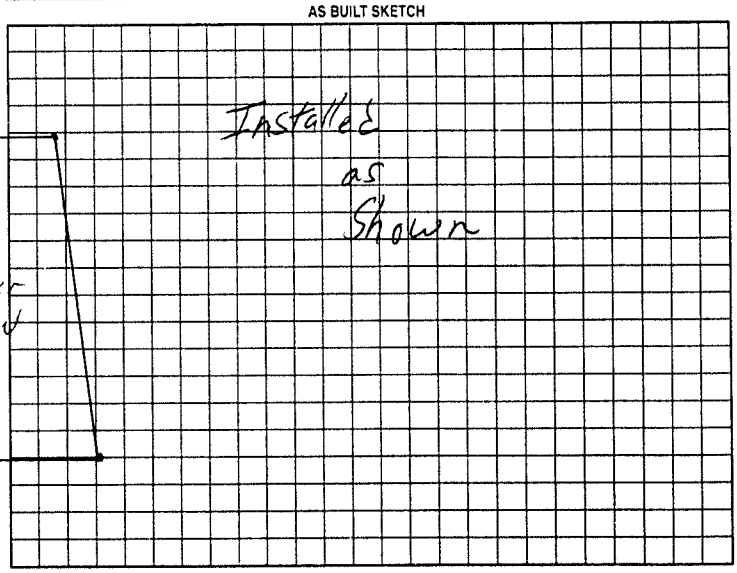

Permit can be suspended or revoked if any false information is supplied toward securing the permit/any unauthorized changes are made to the site/any unauthorized changes are made in the installation of the system. Improvement Permit with plat valid without expiration. Improvement Permit with site plan valid for sixty months. Authorization to Construct is valid for a period equal to that of Improvement Permit – not to exceed sixty months.

Signed: W M Gbur date 1-17-2001 Installed by: Craig Thompson

Improvement Permit by: RS date 10/27/00 Operation Permit by: William Johnson date 1/24/01

Authorization to Construct by: RS date 10/27/00 Existing System Inspection by: date

HEALTH DEPT. COPY. WHITE OWNER COPY (FINAL) YELLOW OWNER COPY (INITIAL) PINK