IREDELL COUNTY HEALTH DEPARTMENT

STATESVILLE 704-878-5305 MOORESVILLE 704-664-5281

IMPROVEMENT PERMIT / AUTHORIZATION TO CONSTRUCT / OPERATION PERMIT / EXISTING SYSTEM INSPECTION

CI

PERMIT# 093894 PIN# ~~4702 85 3081 (pt)~~ 4702-85-4563 DATE Feb 23,01

OWNER OR CONTRACTOR Roger Ottersbach // Eufola Road Properties PHONE: Business 876-8657 Home

ADDRESS 109 Desiree Dr. Statesville N.C. 28677

LOCATION From Trantham Dr on Mtn Rd. TL Celeste-Eufola Rd. TR Eufola TL Desiree on Right

SUBDIVISION Shenandoah BLOCK / SECTION LOT 17 LOT AREA .759 Ac SITE CLASS 45 DESIGN FLOW 360gpd L.T.A.R. .3

Septic Tank: 1000 Gallons; STB 1012 Date 7-16-04

Pump Tank: 1000 Gallons; PT Date

Pump Make: Model Serial No.

Nitrification Field: No Fields 1 Square Feet 1200 Linear Feet 400

No Lines 4 Trench Width 36" Max Trench Bottom Depth 24" Gravel Depth 12"

☑ New System ☐ Repair System Type: I, II, III, IV, V, VI

System Description: Gravity Conventional SAME

Repair System Description:

Maintenance Agreement Required: ☐ Yes ☐ No

☐ House/Mod. Home No. Bedrooms 3

☐ Mobile Home No. Bathrooms 2

☐ Business No. Employees

☐ Other


☐ Slab ☑ Crawl Space ☐ Basement w/plumbing ☐ Basement wo/plumbing

Water Supply: ☐ Individual ☑ Public ☐ Community

Comments:/Conditions: Drop Boxes may be used if sufficient slope exists

Comments:/Conditions: SUB PERMIT ON TREE MATCHED PERMIT # ON SCOPE PERMIT.
TUFF TITE FILTER DRAWING INSTALLED AS DRAWN USING DIST BOX WITH SPLIT LEVELERS

INITIAL SITE SKETCH 1" = 50' 287.19'

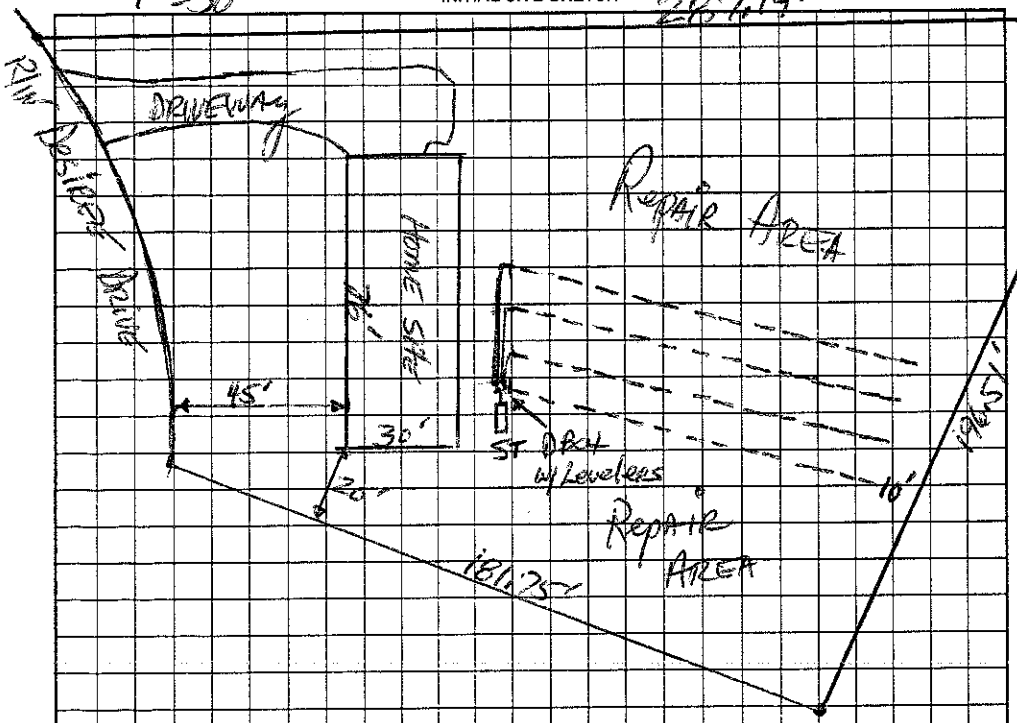

AS BUILT SKETCH

SYSTEM 10' OFF MARKED P/L
SYSTEM INSTALLED BY D/W WAS SET UP

Permit can be suspended or revoked if any false information is supplied toward securing the permit/any unauthorized changes are made to the site/any unauthorized changes are made in the installation of the system. Improvement Permit with plat valid without expiration. Improvement Permit with site plan valid for sixty months. Authorization to Construct is valid for a period equal to that of Improvement Permit – not to exceed sixty months.

Signed: Roger J. Ottersbach II date 4-24-01

Improvement Permit by: date 2-23-01

Authorization to Construct by: date 1/27/04

Installed by: C. THOMPSON

Operation Permit by: date 2-8-05

Existing System Inspection by: date

HEALTH DEPT. COPY: WHITE OWNER COPY (FINAL): YELLOW OWNER COPY (INITIAL): PINK