IREDELL COUNTY HEALTH DEPARTMENT

STATESVILLE 704-878-5305 MOORESVILLE 704-664-5281

IMPROVEMENT PERMIT / AUTHORIZATION TO CONSTRUCT / OPERATION PERMIT / EXISTING SYSTEM INSPECTION

PERMIT# 093876 PIN# 4702 85 5081 (pt) DATE Feb 21, 01

OWNER OR CONTRACTOR Roger Otterbach // Eutola Road Properties PHONE: Business 878-8657 Home

ADDRESS 109 Desiree Dr. Statesville N.C. 28677

LOCATION From Traditions Old Mitchell Rd TL Celeste-Eutola TR Eutola TL Kymile TL Desiree

SUBDIVISION Shenandoah BLOCK / SECTION LOT 5 LOT AREA .586 ac SITE CLASS AS DESIGN FLOW 360gpd L.T.A.R. .3

Septic Tank: 1000 Gallons: STB 1012 Date 3-5-01
Pump Tank: Gallons: PT Date
Pump Make: Model Serial No.
Nitrification Field: No Fields 1 Square Feet 1200 Linear Feet 400
No Lines 5 Trench Width 36" Max Trench Bottom Depth 24"

☑ New System ☐ Repair System Type: I (II) III, IV, V, VI
System Description: GRAVITY CONVENTIONAL
Repair System Description: / SAME
Maintenance Agreement Required: ☐ Yes ☑ No

Gravel Depth 12" ☐ Slab ☑ Crawl Space ☐ Basement w/plumbing ☐ Basement wo/plumbing

☐ House/Mod. Home No. Bedrooms 3
☑ Mobile Home No. Bathrooms 2
☐ Business No. Employees
☐ Other


Water Supply: ☐ Individual ☑ Public ☐ Community

Comments/Conditions: DO NOT ISSUE Authorization to construct until Well Abandonment form is received back from DENR (for lot 4)


Comments/Conditions: 3/8/01 - PINK COPY (A.C.) ALREADY GIVEN PRIOR TO SIGNING OF A.C.
- Polylok Filter Installed; Septic Tank
- marker Installed.

1" = 50'

INITIAL SITE SKETCH

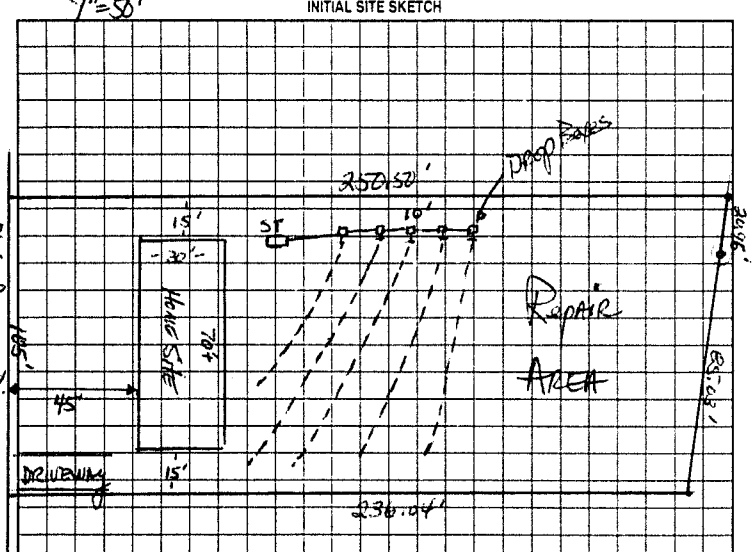

AS BUILT SKETCH Installed 4 lines @ 90' 1 line @ 40'

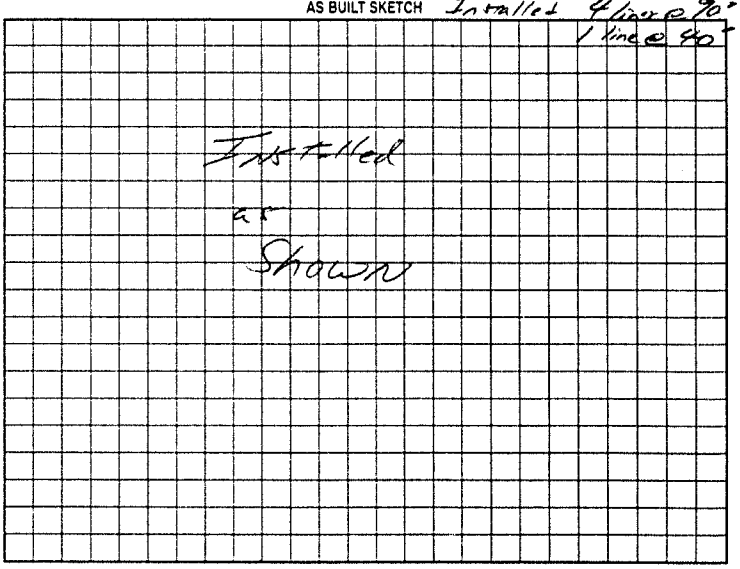

Permit can be suspended or revoked if any false information is supplied toward securing the permit/any unauthorized changes are made to the site/any unauthorized changes are made in the installation of the system. Improvement Permit with plat valid without expiration. Improvement Permit with site plan valid for sixty months. Authorization to Construct is valid for a period equal to that of Improvement Permit – not to exceed sixty months.

Signed: Nancy Otterbach date 2-22-01 Installed by: A-1 Backhoe

Improvement Permit by: [signature] date 2-21-01 Operation Permit by: William O Johnson date 6/26/01

Authorization to Construct by: [signature] date 3/8/01 Existing System Inspection by: date

HEALTH DEPT COPY WHITE OWNER COPY (FINAL) YELLOW OWNER COPY (INITIAL) PINK