IREDELL COUNTY HEALTH DEPARTMENT

STATESVILLE 704-878-5305 MOORESVILLE 704-664-5281

IMPROVEMENT PERMIT / AUTHORIZATION TO CONSTRUCT / OPERATION PERMIT / EXISTING SYSTEM INSPECTION

PERMIT# 093875 PIN# 4702 85 5081 (pt) DATE Feb 21, 01

OWNER OR CONTRACTOR Roger Offerbach / Eutaw Rd Properties PHONE: Business 872-8654 Home

ADDRESS 109 DeBiREE Dr. Statesville N.C. 28677

LOCATION From Trantman Old Allen Rd. TL Celeste Eutaw Rd. TR Eutaw Rd ~ ¼ mile TL Degree Dr. 4th lot on left

SUBDIVISION Shenandoah BLOCK / SECTION LOT 4 LOT AREA 1.621 Ac SITE CLASS PS DESIGN FLOW 480 gpd L.T.A.R. .35-.3

Septic Tank: 1000 Gallons: STB 1072 Date 11-3-00
Pump Tank: Gallons: PT Date
Pump Make: Model Serial No.
Nitrification Field: No Fields 1 Square Feet Linear Feet 480
No Lines 6 @ 80' Trench Width 36" Max Trench Bottom Depth 36"

☑ New System ☐ Repair System Type: I. II. III. IV. V. VI
System Description: Gravity Innovative -25% Red.
Repair System Description: Same
Maintenance Agreement Required: ☐ Yes ☑ No

☑ House/Mod. Home No. Bedrooms 4
☑ Mobile Home DW/MHD No. Bathrooms 3
☐ Business No. Employees
☐ Other

☐ Slab ☑ Crawl Space ☐ Basement w/plumbing ☐ Basement wo/plumbing


Water Supply: ☐ Individual ☑ Public ☐ Community

Comments/Conditions: Do not ISSUE Authorization to construct until well abandonment form is Received back from DENR.

Comments/Conditions 3/8/01 - PINK COPY (A.C.) ALREADY GIVEN PRIOR TO SIGNING OF A.C.

1"=50'

INITIAL SITE SKETCH

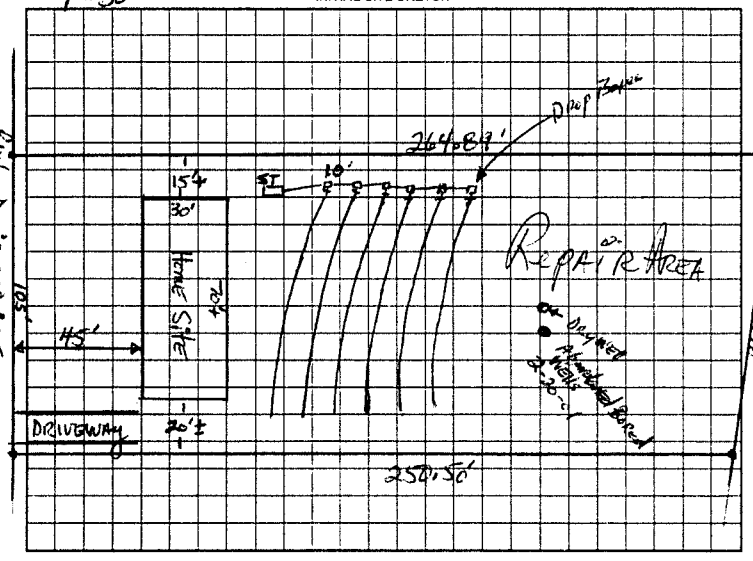

AS BUILT SKETCH

INSTALLED AS SHOWN WITH POLYFLOW FEEDER & EMITTERS

Permit can be suspended or revoked if any false information is supplied toward securing the permit/any unauthorized changes are made to the site/any unauthorized changes are made in the installation of the system. Improvement Permit with plat valid without expiration. Improvement Permit with site plan valid for sixty months. Authorization to Construct is valid for a period equal to that of Improvement Permit – not to exceed sixty months.

Signed: Nancy Offerbach date 2-22-01 Installed by: A-1 Backhoe

Improvement Permit by: Mark Johnson, RS date 2-21-01 Operation Permit by: Jim Cook RS I date 03-22-01

Authorization to Construct by: Nancy RS date 3/02/01 Existing System Inspection by: date

HEALTH DEPT. COPY: WHITE OWNER COPY (FINAL): YELLOW OWNER COPY (INITIAL): PINK