IREDELL COUNTY HEALTH DEPARTMENT

STATESVILLE 704-878-5305 MOORESVILLE 704-664-5281

IMPROVEMENT PERMIT / AUTHORIZATION TO CONSTRUCT / OPERATION PERMIT / EXISTING SYSTEM INSPECTION

PERMIT# 893870 PIN# 4702 85 5081(pt) DATE Feb 21, 01

OWNER OR CONTRACTOR Roger Otterstedt // Eufola Road Properties PHONE: Business 878-6654 Home

ADDRESS 109 Desiree Dr. Statesville N.C. 28677

LOCATION From Tomlinson Old Mill Rd. TL Celeste-Eufola TR Eufola TL Desiree 3rd lot on left

SUBDIVISION Shenandoah BLOCK / SECTION LOT 3 LOT AREA .656ac SITE CLASS. KS DESIGN FLOW 360 gpd L.T.A.R. .25-.3

Septic Tank: 1000 Gallons: STB 1012 Date 3-25-01
Pump Tank: Gallons: PT Date
Pump Make: Model Serial No
Nitrification Field: No Fields 1 Square Feet 1275 Linear Feet 425
No Lines 5 Trench Width 36" Max Trench Bottom Depth 36" Gravel Depth 12"

☑ New System ☐ Repair, System Type: I, II, III, IV, V, VI
System Description: Capacity Conventional
Repair System Description: same
Maintenance Agreement Required: ☐ Yes ☑ No

☐ House/Mod. Home No. Bedrooms 3
☑ Mobile Home Dbl/mod No. Bathrooms 2
☐ Business No. Employees
☐ Other
☐ Slab ☑ Crawl Space ☐ Basement w/plumbing ☐ Basement wo/plumbing


Water Supply: ☐ Individual ☑ Public ☐ Community

Comments/Conditions: Do not issue Authorization to construct until well Abandonment form is received back from DENR for lot 4.


Comments/Conditions: 3/9/01 - PINK COPY (A.C.) ALREADY GIVEN PRIOR TO SIGNING OF A.C.
- Polylok Filter Installed
- Septic Tank marker Installed

1"=50'

INITIAL SITE SKETCH

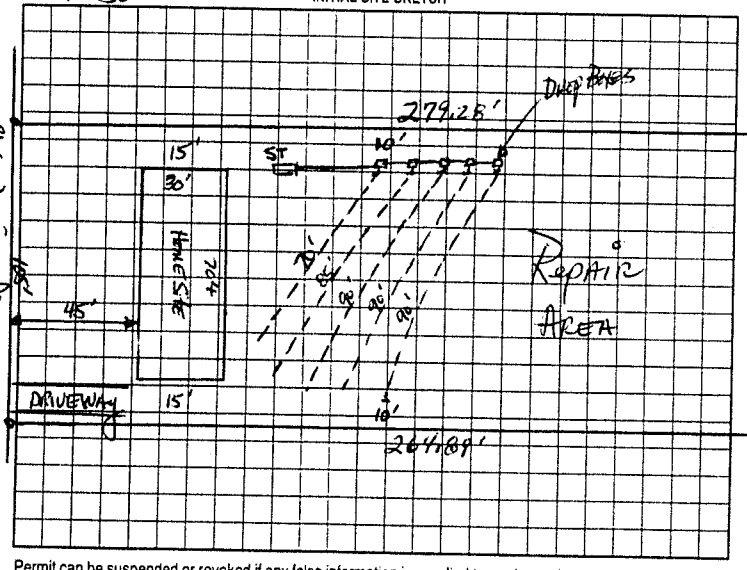

AS BUILT SKETCH

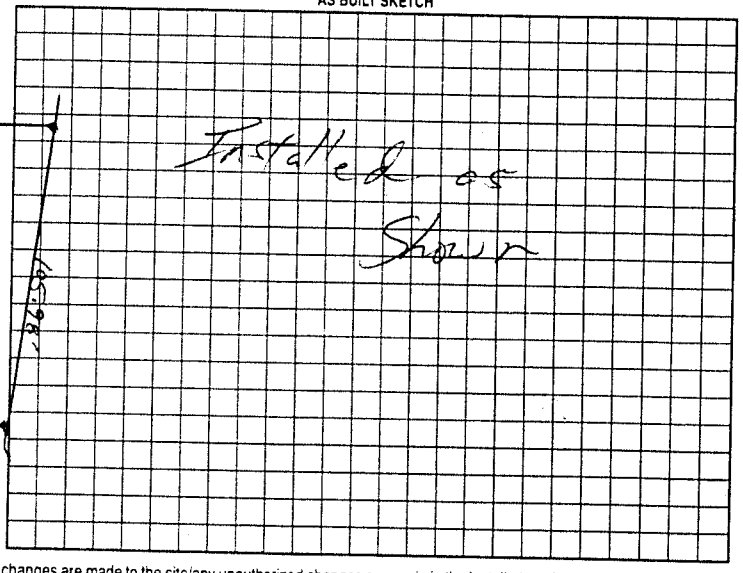

Permit can be suspended or revoked if any false information is supplied toward securing the permit/any unauthorized changes are made to the site/any unauthorized changes are made in the installation of the system. Improvement Permit with plat valid without expiration. Improvement Permit with site plan valid for sixty months. Authorization to Construct is valid for a period equal to that of Improvement Permit – not to exceed sixty months.

Signed: Nancy Otterstedt date 2-22-01
Improvement Permit by: [signature], RS date 2-21-01
Authorization to Construct by: [signature] date 3/8/01

Installed by: A-1 Backhoe
Operation Permit by: William O. Johnson date 6/6/01
Existing System Inspection by: date

HEALTH DEPT COPY: WHITE OWNER COPY (FINAL): YELLOW OWNER COPY (INITIAL): PINK