IREDELL COUNTY HEALTH DEPARTMENT

STATESVILLE 704-878-5305 MOORESVILLE 704-664-5281

IMPROVEMENT PERMIT / AUTHORIZATION TO CONSTRUCT / OPERATION PERMIT / EXISTING SYSTEM INSPECTION

PERMIT# 093862 PIN# 4702-85-5081 (pt.) DATE 2/6/01

OWNER OR CONTRACTOR Roger Ottersbach / Eutola Road Prop. PHONE: Business 875-8654 Home

ADDRESS 109 Destiny Dr. Statesville NC - 28677

LOCATION From Troutman Old Wilkesboro Rd TL Celeste-Eutola TR Eutola ~ ¼ mile TL Desiree 2nd lot on left

SUBDIVISION Shenandoah BLOCK / SECTION LOT 2 LOT AREA 1.691 ac SITE CLASS PS DESIGN FLOW 480 gpd L.T.A.R. .3

Septic Tank: 1000 Gallons: STB 1012 Date 11-2-00
Pump Tank: Gallons: PT Date
Pump Make: Model Serial No.
Nitrification Field: No Fields 1 Square Feet 1200 Linear Feet 400
No Lines 5 Trench Width 36" Max Trench Bottom Depth 36" Gravel Depth

☑ New System ☐ Repair System Type: I, II, III, IV, V, VI
System Description: GRAVITY CONVENTIONAL - 25% Red.
Repair System Description: SAME
Maintenance Agreement Required: ☐ Yes ☑ No


☐ House/Mod. Home No. Bedrooms 4
☑ Mobile Home Dbl/wide No. Bathrooms 3
☐ Business No. Employees
☐ Other
☐ Slab ☑ Crawl Space ☐ Basement w/plumbing ☐ Basement wo/plumbing

Water Supply: ☐ Individual ☐ Public ☐ Community


Comments/Conditions: Do not issue authorization to construct until the new septic system for lot 1 is installed, approved, hooked to house plumbing and old drainfield is removed

Comments/Conditions: 3/2/01 - PINK COPY (A.C.) ALREADY GIVEN PRIOR TO SIGNING OF A.C. 10' back side of the Lot 1-2 site property line. DPH

INITIAL SITE SKETCH

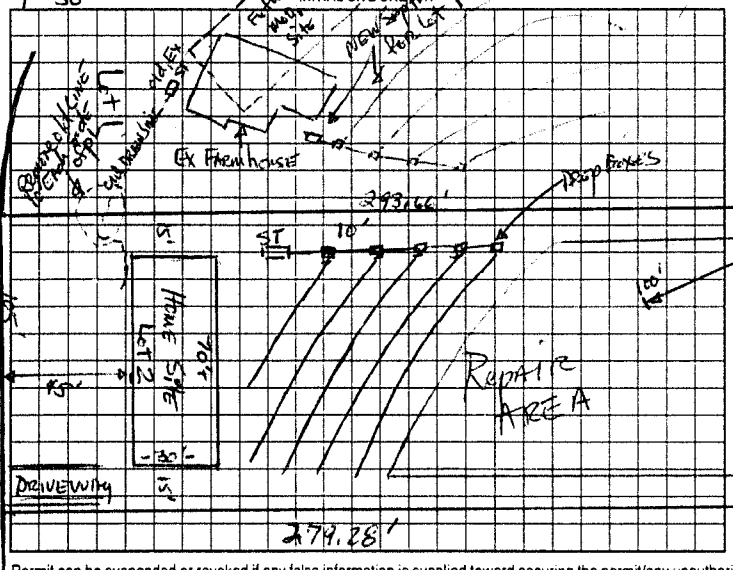

AS BUILT SKETCH

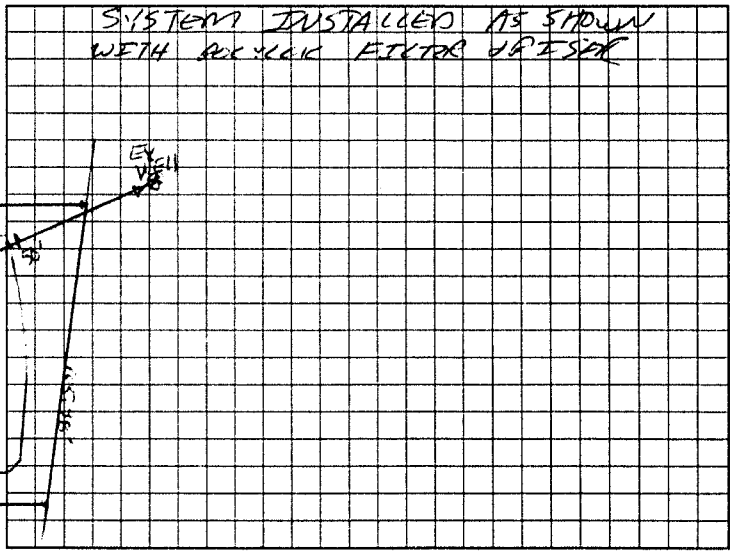

Permit can be suspended or revoked if any false information is supplied toward securing the permit/any unauthorized changes are made to the site/any unauthorized changes are made in the installation of the system. Improvement Permit with plat valid without expiration. Improvement Permit with site plan valid for sixty months. Authorization to Construct is valid for a period equal to that of Improvement Permit – not to exceed sixty months.

Signed: Roger Ottersbach date 2-22-01 Installed by: A-1 BACK HOE

Improvement Permit by: date 2/6/01 Operation Permit by: RST date 03-28-01

Authorization to Construct by: date 3/8/01 Existing System Inspection by: date

HEALTH DEPT. COPY: WHITE OWNER COPY (FINAL): YELLOW OWNER COPY (INITIAL): PINK