# IREDELL COUNTY HEALTH DEPARTMENT

STATESVILLE 704-878-5305 MOORESVILLE 704-664-5281

## IMPROVEMENT PERMIT / AUTHORIZATION TO CONSTRUCT / OPERATION PERMIT / EXISTING SYSTEM INSPECTION

PERMIT# 093864 PIN# 4702 85 5081 (pt.) DATE Feb 9 01

OWNER OR CONTRACTOR Roger J. Ottersbach // Eufola Road Prop. PHONE: Business _____ Home _____

ADDRESS 109 Dalinee DR. Statesville N.C. 28677

LOCATION From Troutman Old NAN Rd. TL Celeste-Eufola Rd TR Eufola RD. ~ 1/4 mile TL Desiree 1st lot on left

SUBDIVISION Shenandoah BLOCK / SECTION _____ LOT 1 LOT AREA 1.045 ac SITE CLASS P3 DESIGN FLOW 360 gpd L.T.A.R. .83

Septic Tank: 1000 Gallons. STB 1012 Date 11-9-00

Pump Tank: _____ Gallons. PT _____ Date _____

Pump Make: _____ Model _____ Serial No _____

Nitrification Field: No Fields 1 Square Feet 1200 Linear Feet 400

No Lines 4 Trench Width 36" Max Trench Bottom Depth 36"

☒ New System ☐ Repair System Type: I II III IV V VI

System Description: GRAVITY CONVENTIONAL

Repair System Description: Pumped CONV/INNOVATIVE

Maintenance Agreement Required ☐ Yes ☒ No

Gravel Depth 12" ☐ Slab ☒ Crawl Space ☐ Basement w/plumbing ☐ Basement wo/plumbing

☒ House/Mod. Home No. Bedrooms 3

☐ Mobile Home No. Bathrooms 2

☐ Business No. Employees _____

☐ Other _____

Water Supply: ☐ Individual ☒ Public ☐ Community

Comments/Conditions:


Recommend pumping out and filling in old Existing Septic tank.

Comments/Conditions


* House to be hooked up to West Iredell Water Corp. ASAP. Bored wells on Lot 4 to be properly abandoned.

INITIAL SITE SKETCH

1" = 50'

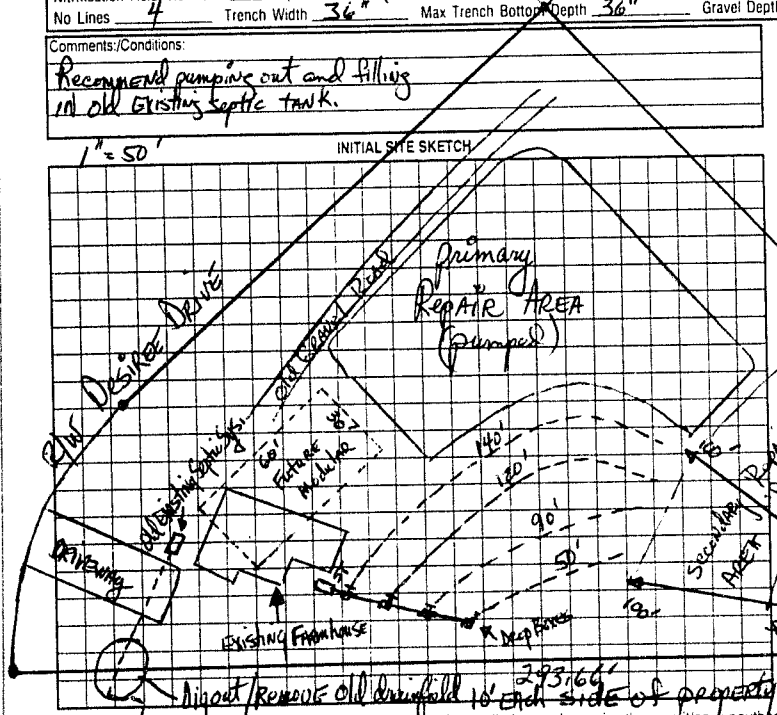


AS BUILT SKETCH

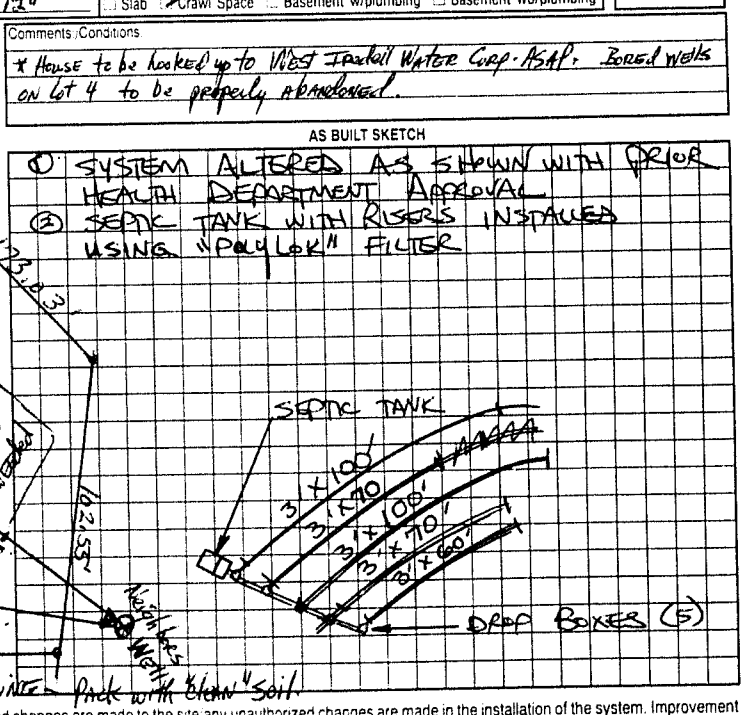


Dig out/Remove Old drainfield 10' each side of property Line - Back with clean soil. 293.66'

Permit can be suspended or revoked if any false information is supplied toward securing the permit/any unauthorized changes are made to the site/any unauthorized changes are made in the installation of the system. Improvement Permit with plat valid without expiration. Improvement Permit with site plan valid for sixty months. Authorization to Construct is valid for a period equal to that of Improvement Permit – not to exceed sixty months.

Signed: * Roger J. Ottersbach date 1-9-01

Improvement Permit by: Mark Hyman IRS date 2-9-01

Authorization to Construct by: Mark Hyman IRS date 2-9-01

Installed by: STATESVILLE BACKHOE

Operation Permit by: STEVE HEDRICK date 2-21-01

Existing System Inspection by: _____ date _____

HEALTH DEPT COPY: WHITE OWNER COPY (FINAL): YELLOW OWNER COPY (INITIAL): PINK