63465

IREDELL COUNTY HEALTH DEPARTMENT

STATESVILLE 704-878-5305 MOORESVILLE 704-664-5281

IMPROVEMENT PERMIT / CERTIFICATE OF COMPLETION / OPERATION PERMIT / EXISTING SYSTEM INSPECTION

PROPERTY DESCRIPTION NO. 24986 DATE 9-17-96 TAX MAP NO. 8C-B-8A Pt of Watershed: ☑ Yes ☐ No

OWNER OR CONTRACTOR Sunwood Builders PHONE: Business 872 0922 Home

ADDRESS PO Box 5877 Statesville WS IV-PA

LOCATION Now Eufola Rd before Celeste Eufola Rd

SUBDIVISION Key acres BLOCK / SECTION LOT 3 LOT AREA 1.474 acres SITE CLASS. PS DESIGN FLOW 360 L.T.A.R. .3

Septic Tank: 1000 Gallons: STB 1012 Date 7-18-96

Pump Tank: Gallons: PT Date

Pump Make: Model Serial No.

Nitrification Field: No Fields 1 Square Feet 1200 Linear Feet 400

No Lines 4 Trench Width 36" Max Trench Bottom Depth 36" Gravel Depth 12"

☑ New System ☐ Repair System Type: I, II, III, IV, V, VI

System Description: Conv. Gravity

Repair System Description: Pump to conv.

Maintenance Agreement Required: ☐ Yes ☐ No

☐ House/Mod. Home ☑ Mobile Home ☐ Business ☐ Other

No. Bedrooms 3 No. Bathrooms 2 No. Employees


☐ Slab ☑ Crawl Space ☐ Basement w/plumbing ☐ Basement wo/plumbing

Water Supply: ☑ Individual ☐ Community ☐ Public


Comments:

Comments:

INITIAL SITE SKETCH

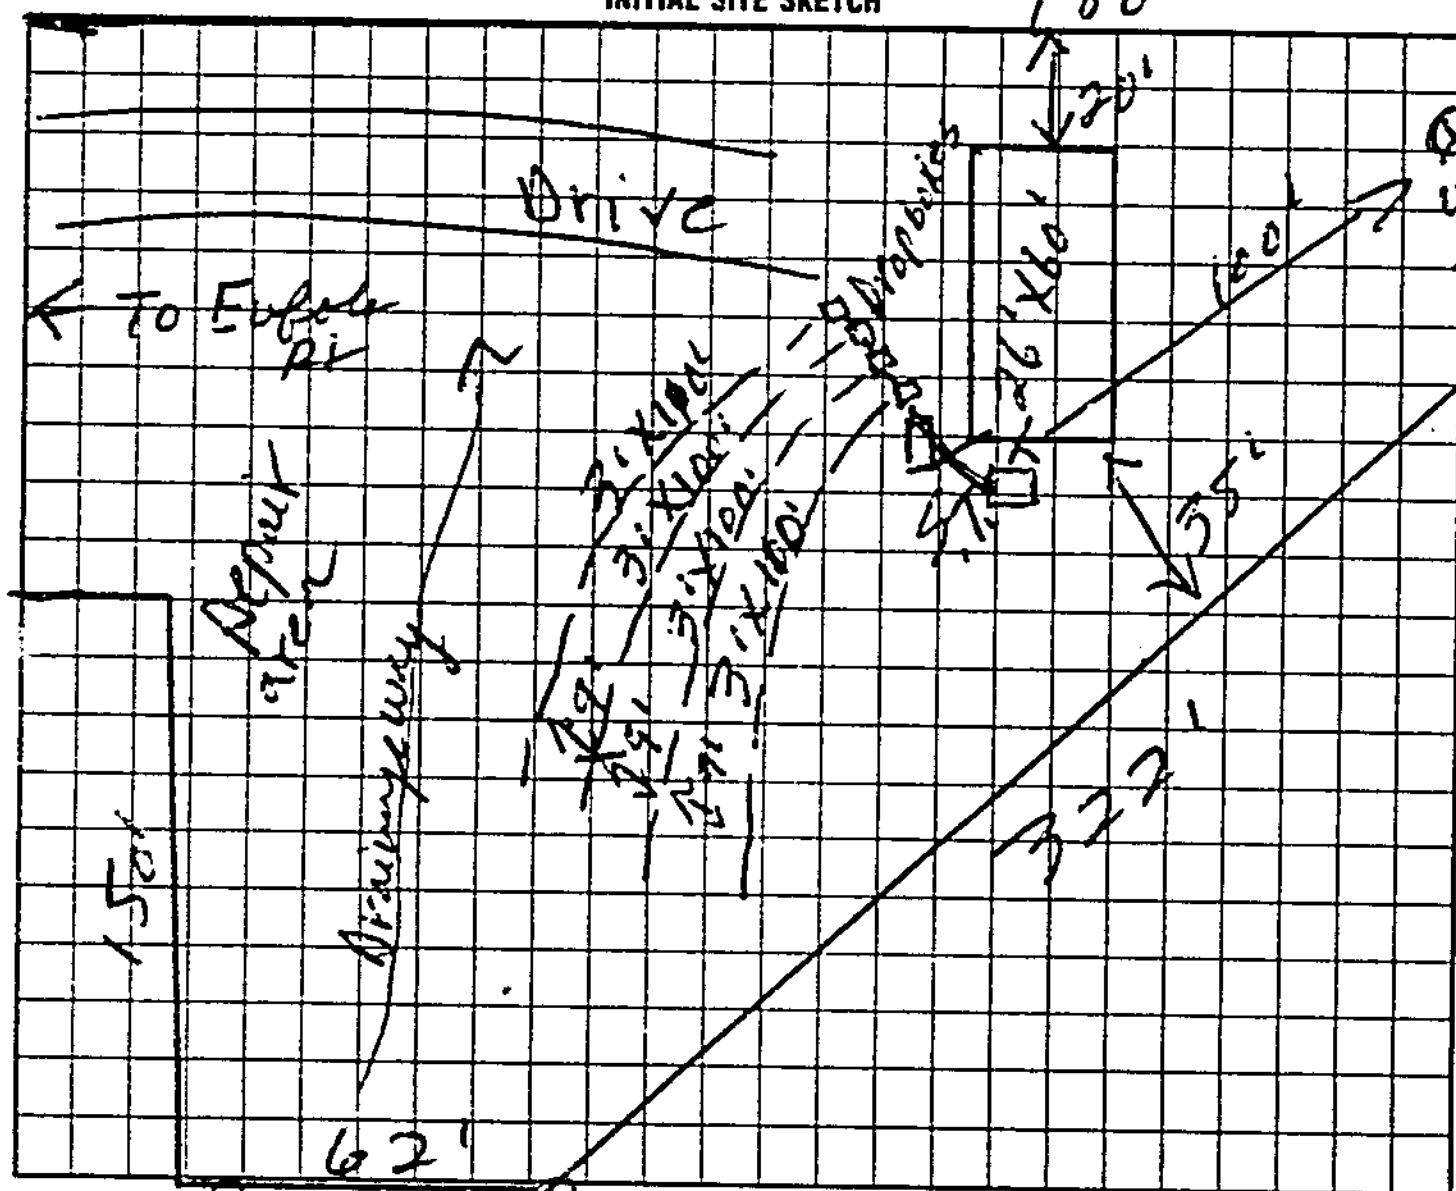

AS BUILT SKETCH

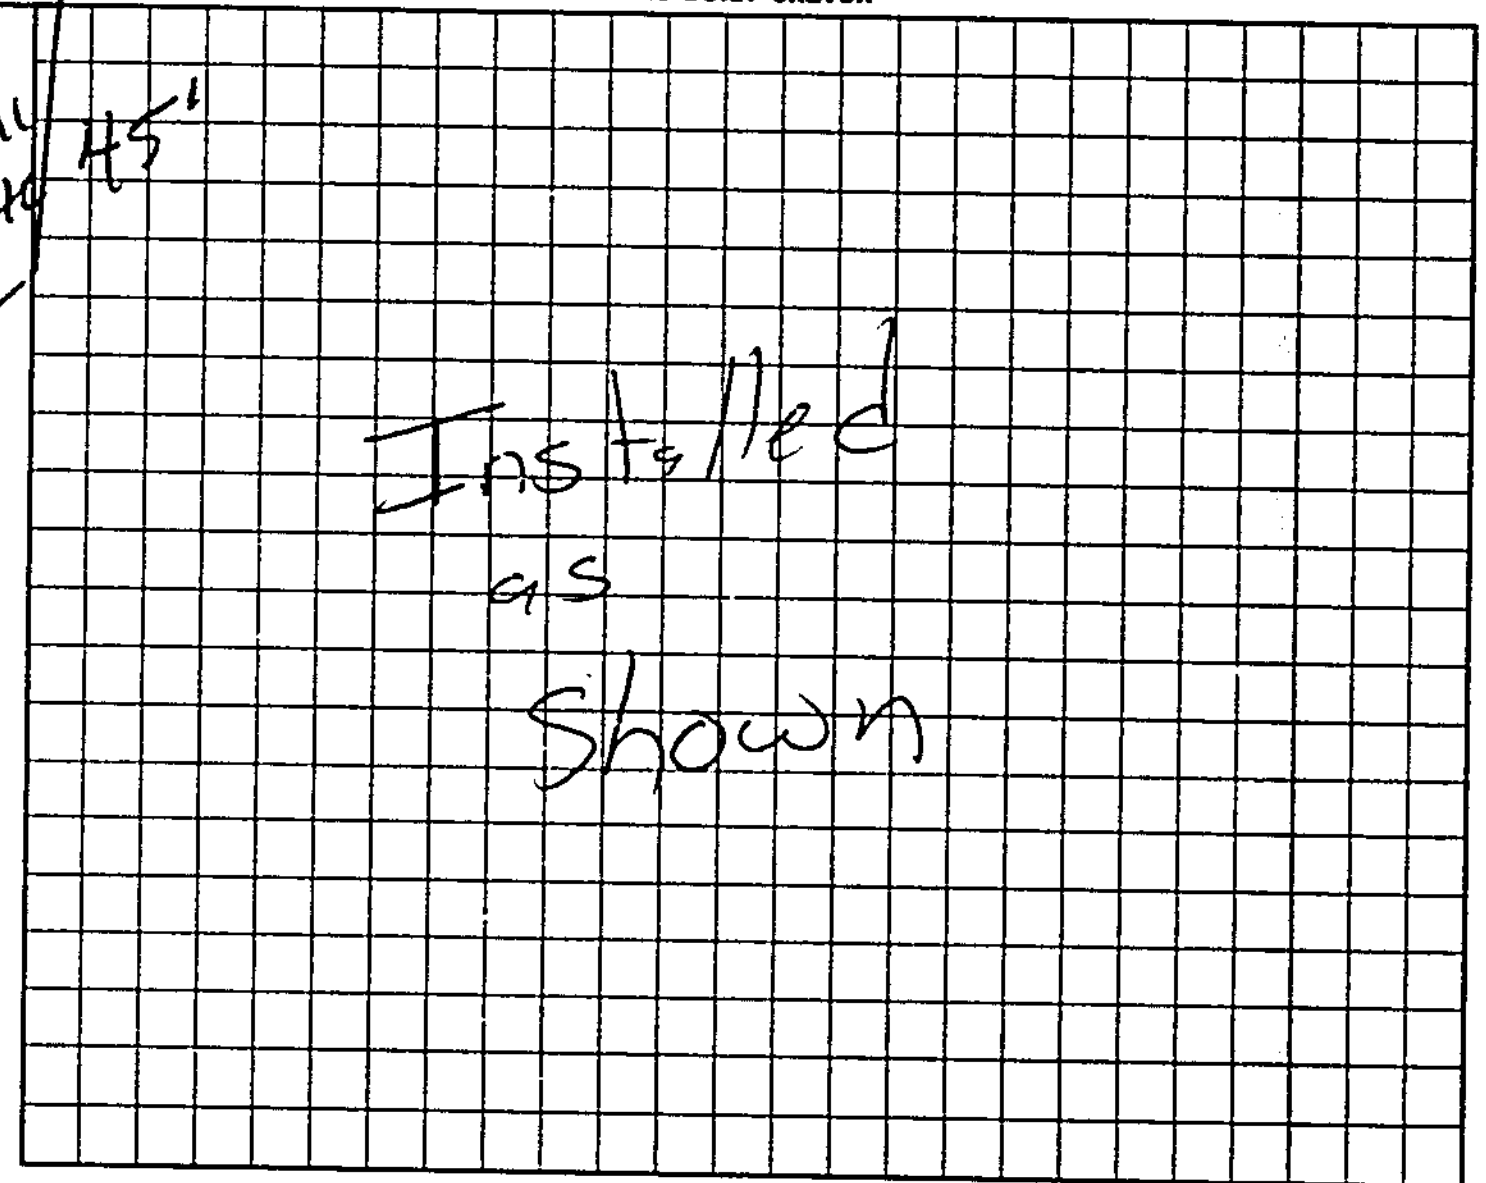

I understand that this permit can be suspended or revoked if any false information is supplied toward securing the permit/any unauthorized changes are made to the site/any unauthorized changes are made in the installation of the system.

Signed: Perry W. Baker

Improvement Permit by: P. C. Moore date 9-17-96

~~Existing System Inspection by:~~ Authorization to construct P. C. Moore date 9-17-96

Installed by: Tommy Cothren

~~Certificate of Completion by:~~ date

Operation Permit by: Mat C O RS date 10-21-96

HEALTH DEPT. COPY WHITE INSPECTION COPY (FINAL) GREEN OWNER COPY (FINAL) YELLOW INSPECTION COPY (INITIAL) PINK OWNER COPY (INITIAL) GOLD

Authorization to const. Expires 60 mos from issue