63.465

IREDELL COUNTY HEALTH DEPARTMENT

STATESVILLE 704-878-5305 MOORESVILLE 704-664-5281

IMPROVEMENT PERMIT / CERTIFICATE OF COMPLETION / OPERATION PERMIT / EXISTING SYSTEM INSPECTION

PROPERTY DESCRIPTION NO. 24986 DATE 9-17-96 TAX MAP NO. 8C-B-8A Pt of Watershed: ☐ Yes ☐ No

OWNER OR CONTRACTOR Sunwood Builders PHONE: Business 872 0722 Home

ADDRESS P.O. Box 5577 Statesville

LOCATION Rt 21 to Emfola Pl before Celeste Emfola Pl

SUBDIVISION Key Acres BLOCK / SECTION LOT 3 LOT AREA 1.474 acres SITE CLASS IIS DESIGN FLOW 360 L.T.A.R. 1.3

Septic Tank: 1000 Gallons: STB 10 12 Date 9-18-96

Pump Tank: Gallons: PT Date

Pump Make: Model Serial No.

Nitrification Field: No Fields 1 Square Feet 1200 Linear Feet 400

No Lines 4 Trench Width 36" Max Trench Bottom Depth 36" Gravel Depth 12"

☑ New System ☐ Repair System Type: ☐ I ☐ II ☐ III ☐ IV ☐ V ☐ VI

System Description: Conv. Gravity

Repair System Description: Pump To Conv.

Maintenance Agreement Required: ☐ Yes ☐ No

☑ House/Mod. Home ☐ Mobile Home ☐ Business ☐ Other

No. Bedrooms 3 No. Bathrooms 2 No. Employees


☐ Slab ☑ Crawl Space ☐ Basement w/plumbing ☐ Basement w/o plumbing

Water Supply: ☑ Individual ☐ Community ☐ Public

Comments:

Comments:

INITIAL SITE SKETCH

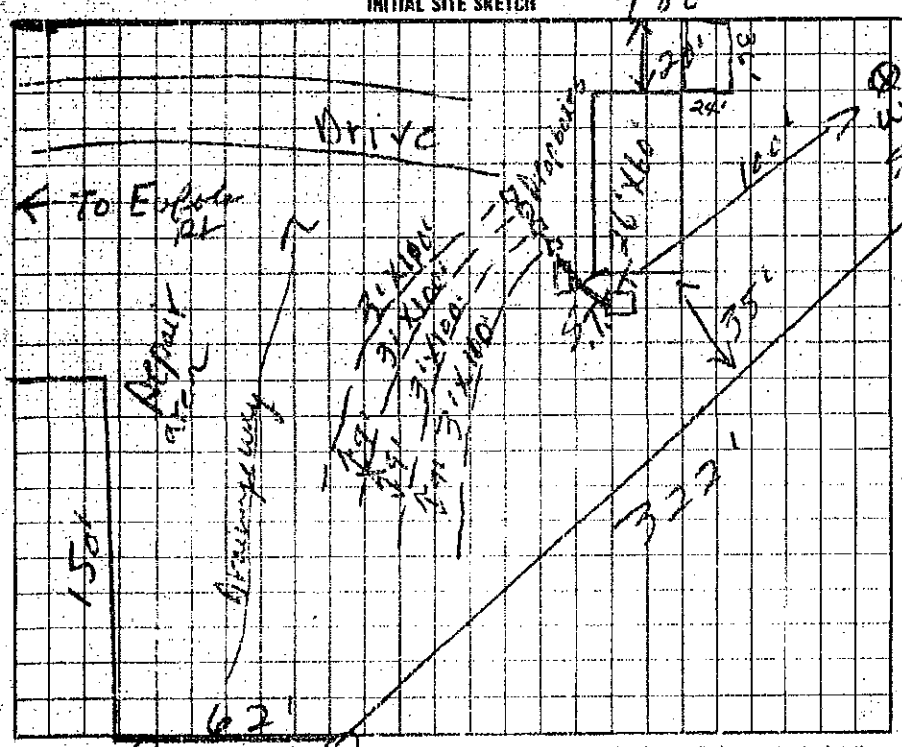

AS BUILT SKETCH

Existing as Shown

The proposed Pole Building 24 x 36 addition does not appear to impact the existing septic system.

**NOTE: Must remain 25' from well

R.S.

Date: 2-16-2010

ICHD-Environmental Health Division

I understand that this permit can be suspended or revoked if any false information is supplied toward securing the permit/any unauthorized changes are made to the site/any unauthorized changes are made in the installation of the system.

Signed:

Installed by: Tommy Cothren

Improvement Permit by: R.C. Moore date 9-17-96

Existing System Inspection by: R.C. Moore date 9-17-96

Certificate of Completion by: date

Operation Permit by: RS date 10-21-96

Authorization to Connect

4 to Conn. (PINK) COPY (WHITE) INSPECTION COPY (FINAL) GREEN OWNER COPY (FINAL) YELLOW INSPECTION COPY (INITIAL) PINK OWNER COPY (INITIAL) GOLD

FEB. 27, 1989 16:24