Authorization to Construct

2:00 Tommy Coffren

IRED. COUNTY HEALTH DEPARTMENT

STATESVILLE 704-878-5305 MOORESVILLE 704-664-5281

IMPROVEMENT PERMIT / CERTIFICATE OF COMPLETION / OPERATION PERMIT / EXISTING SYSTEM INSPECTION

PROPERTY DESCRIPTION NO. 24435 DATE 8/7/96 TAX MAP NO. 8C A 8A Watershed: ☐ Yes ☒ No

OWNER OR CONTRACTOR Sam Hudson PHONE: Business Home 872-0721

ADDRESS PO Box 5879 Statesville, NC. 28687

LOCATION ELFOLA RD; I40 TL OMR TR LEWIS FERRY RD. TL ELFOLA RD. APPROX 1/2 mile on (R)

SUBDIVISION KEY ACRES BLOCK / SECTION LOT 1 LOT AREA ~.7 AC SITE CLASS PS DESIGN FLOW 360 L.T.A.R. .4

Septic Tank: 1000 Gallons; STB 1012 Date 5-4-96

Pump Tank: Gallons; PT Date

Pump Make: Model Serial No.

Nitrification Field: No Fields 1 Square Feet 900 Linear Feet 300

No Lines 3@4 Trench Width 36" Max Trench Bottom Depth 36" Gravel Depth 12"

☒ New System ☐ Repair System Type: I (II) III. IV. V. VI

System Description: CONVENT - DIST BOX

Repair System Description:

Maintenance Agreement Required: ☐ Yes ☐ No

☐ House/Mod. Home No. Bedrooms 3

☒ Mobile Home No. Bathrooms 2

☐ Business No. Employees

☐ Other


☐ Slab ☒ Crawl Space ☐ Basement w/plumbing ☐ Basement wo/plumbing

Water Supply: ☐ Individual ☐ Community ☐ Public


Comments: Pipe under driveway run through 6" Bal. Culvert of ductile iron

Comments:

INITIAL SITE SKETCH 1" = 50'

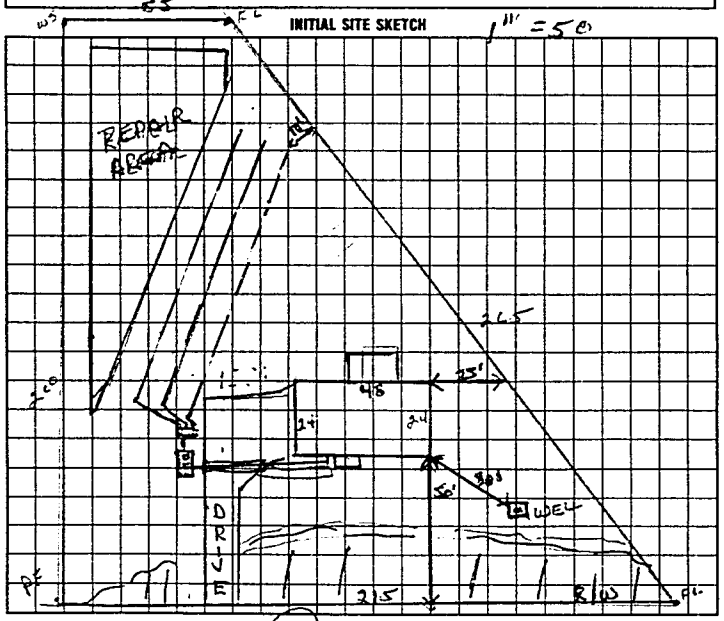

AS BUILT SKETCH

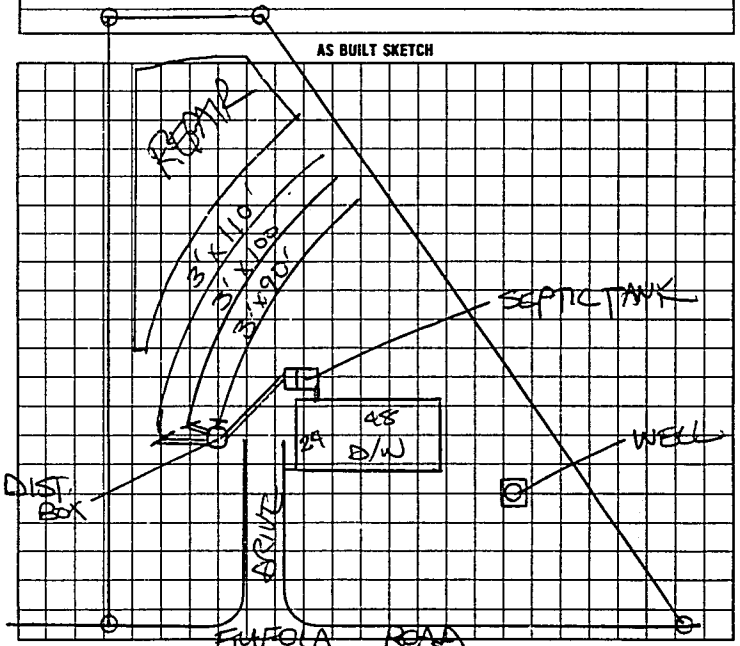

I understand that this permit can be suspended or revoked if any false information is supplied toward securing the permit/any unauthorized changes are made to the site/any unauthorized changes are made in the installation of the system.

Signed: ELFOLA RD. Authorization to construct valid 60 months.

Improvement Permit by: Wesley Sparks RS date 8/7/96

Existing System Inspection by: Authorization to construct Wesley Sparks RS date 8/7/96

Installed by: TOMMY COFFREY

Certificate of Completion by: date

Operation Permit by: STEVE HENDRICK date 8-1996

HEALTH DEPT COPY WHITE | INSPECTION COPY (FINAL) GREEN | OWNER COPY (FINAL) YELLOW | INSPECTION COPY (INITIAL) PINK | OWNER COPY (INITIAL) GOLD

7 3 2 0 0