IREDELL COUNTY HEALTH DEPARTMENT

STATESVILLE 704-878-5305 MOORESVILLE 704-664-5281

IMPROVEMENT PERMIT / AUTHORIZATION TO CONSTRUCT / OPERATION PERMIT / EXISTING SYSTEM INSPECTION

PERMIT# 077348 PIN# 4702 86 0119 DATE 10-31-98

OWNER OR CONTRACTOR VERNON A. CLARK, JR PHONE: Business Home (704) 784-5472

ADDRESS 3033 JESSICA LANE, CONCORD NC 28025

LOCATION BUFFALO SHOALS ROAD, TR EUFOLA RD TL BARBARY DRIVE, 1ST LOT ON RIGHT

SUBDIVISION LANSDOWNE BLOCK / SECTION LOT 56 LOT AREA 1.37 ACRES SITE CLASS PS1 DESIGN FLOW 360 L.T.A.R. 0.30 GPD/FT²

Septic Tank: 1000 Gallons: STB 1012 Date 10-24-98 — New System / Repair — System Type: Conventional

Pump Tank: Gallons: PT Date — System Description: CONVENTIONAL GRAVITY

Pump Make: Model Serial No — Repair System Description CONV. GRAVITY

Nitrification Field: No Fields Square Feet 1200 Linear Feet 400 — Maintenance Agreement Required Yes / No

No Lines FOUR Trench Width 36" Max Trench Bottom Depth 36" Gravel Depth 12" — Slab / Crawl Space / Basement w/plumbing / Basement wo/plumbing


House/Mod Home / Mobile Home / Business / Other — No Bedrooms 3 — No Bathrooms 2 — No Employees

Water Supply: ☐ Individual ☑ Public ☐ Community


Comments/Conditions:

Comments/Conditions: mobile Home Not on site at Time of Inspection

INITIAL SITE SKETCH

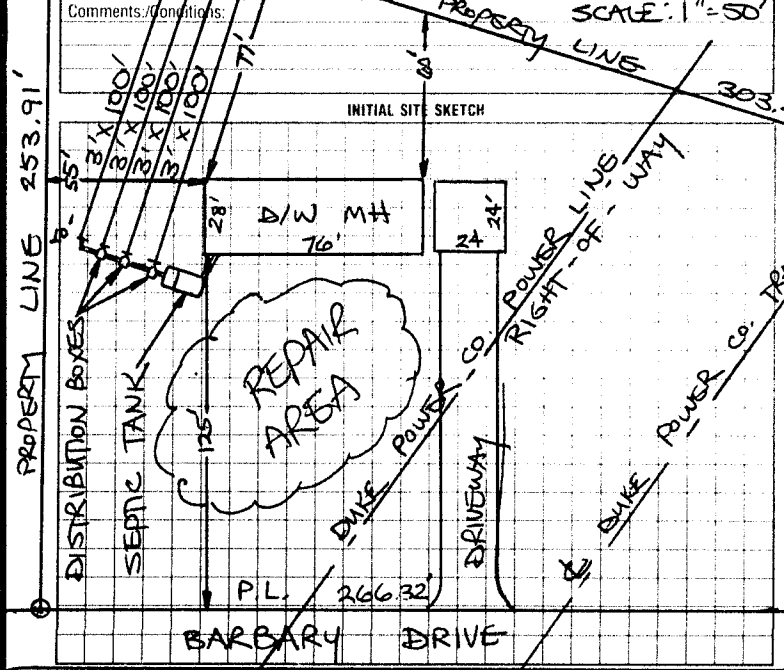

AS BUILT SKETCH

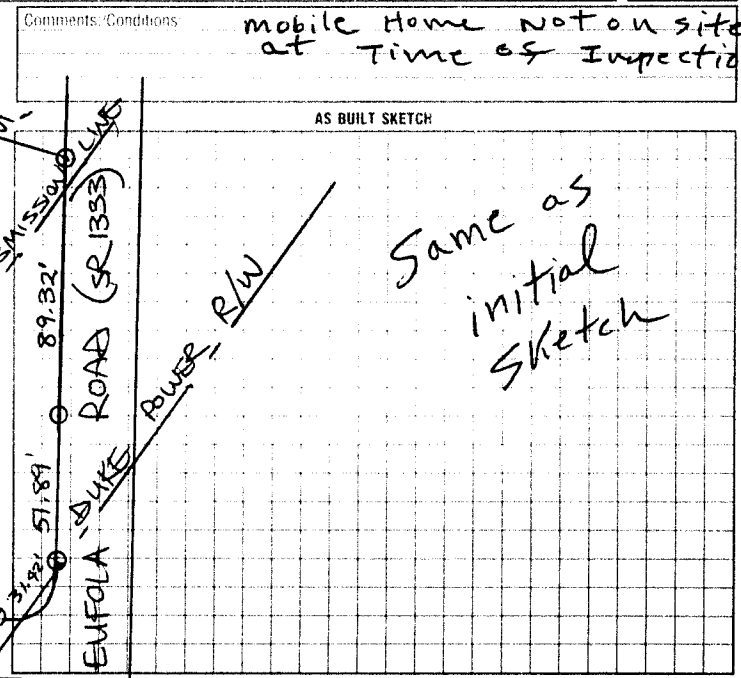

I understand that this permit can be suspended or revoked if any false information is supplied toward securing the permit/any unauthorized changes are made to the site/any unauthorized changes are made in the installation of the system. Improvement Permit with plat valid without expiration. Improvement Permit with site plan valid for sixty months. Authorization to Construct is valid for a period equal to that of Improvement Permit – not to exceed sixty months.

Signed: Vernon A. Clark date 10-31-98 Installed by: A-1 Backhoe

Improvement Permit by: STEVE HEDRICK date 10-31-98 Operation Permit by: J.C. Moore date 1-14-99

Authorization to Construct by: STEVE HEDRICK date 10-31-98 Existing System Inspection by: date

HEALTH DEPT. COPY: WHITE INSPECTION COPY (FINAL): GREEN OWNER COPY (FINAL): YELLOW INSPECTION COPY (INITIAL): PINK OWNER COPY (INITIAL): GOLD