IREDELL COUNTY HEALTH DEPARTMENT

Statesville Phone TR 3-7271 Mooresville Phone NO 3-1271

PERMIT TO INSTALL SEPTIC TANK

Permit NO. Nothers upright Permit Date May 28 1969

Owner Wells Construction Co. Address Chas.

Installed By C Hoke & Sons. Address Ft Stk.


Location of Property Enfola N.C. - Enfola Rd. off Buffalo Shoals Rd. toward Enfola - cross R.R. on R. past junk yard. off Rd.

Tank		Capacity		Length of Lines		Fixtures	
Block	( )	1000	( )	225'	( )	No. of Baths	(1)
Precast	(✓)	1250	( )	250'	( )	Dishwasher	( )
Lash		1500	( )	Other		Garbage Grdr.	( )
		Other				Other	

NOTIFY HEALTH DEPARTMENT AT LEAST EIGHT HOURS BEFORE TANK IS TO BE INSPECTED.

Final Inspection 19 Approved (✓) Disapproved ( )

Remarks No well this prop - Wooded. - Light Soil.

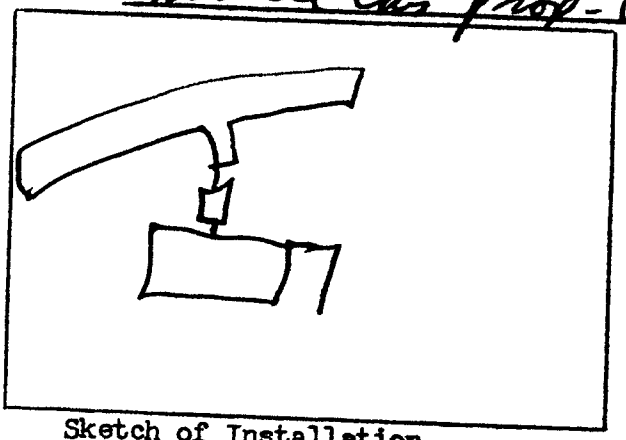

Sketch of Installation

Sanitarian