IREDELL COUNTY HEALTH DEPARTMENT

Statesville Office (704) 878-5305 Mooresville Office (704) 660-3625 PERMIT # 177513

IMPROVEMENT PERMIT / AUTHORIZATION TO CONSTRUCT / OPERATION PERMIT / EXISTING SYSTEM

PIN # 4702872027

APPLICANT: Heritage Building Company of Statesville APPLICANT ADDRESS: 120 Hickory Point Court

SITE ADDRESS: Between 791 and 811 Eufola Rd. PHONE: 704-546-3314 ALT. PHONE:

SITE DIRECTIONS: On Eufola Rd, directly across from Clark's Chapel Baptist Church

SUBDIVISION: n/a SECTION: n/a LOT # LOT AREA: 7.542 DESIGN FLOW: 480 L.T.A.R.: .3

Septic Tank 1000 (gal) STB 1000 Date 5/12
Pump Tank (gal) PT Date
Pump Make Model Serial #
Nitrification Fields 1 # Lines 4 Linear Ft: 400
Trench Width 36" Max. Trench Bottom Depth 36" Gravel Depth n/a

☒ New System ☐ Repair ☐ Expansion System Type: I II (III) IV V VI
System Description: 25% Reduction Gravity
Repair System Description: 25% Reduction Gravity
Maintenance Agreement Required: ☐ YES ☒ NO
☒ GRAVITY ☐ PRESSURE

☒ Residence No. Bedrooms 4
☐ Business No. Persons
☐ Other No. Employees
☐ Slab ☒ Crawl Space
☐ Basement w/plumbing ☐ Basement w/o plumbing


Water Supply: ☐ Private ☒ Public ☐ Community

Comments / Conditions:


TP STB 1012
POLYLOC

SYSTEM INSTALLED AS DESIGNED

INITIAL SITE SKETCH

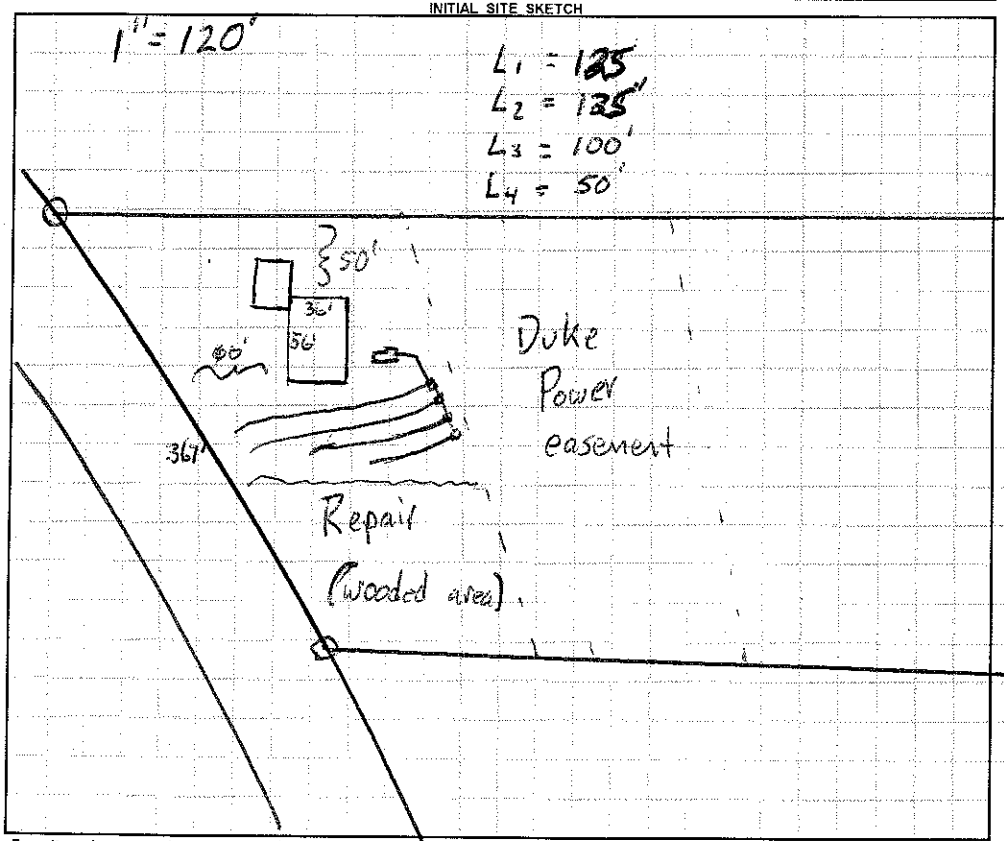

AS BUILT SKETCH

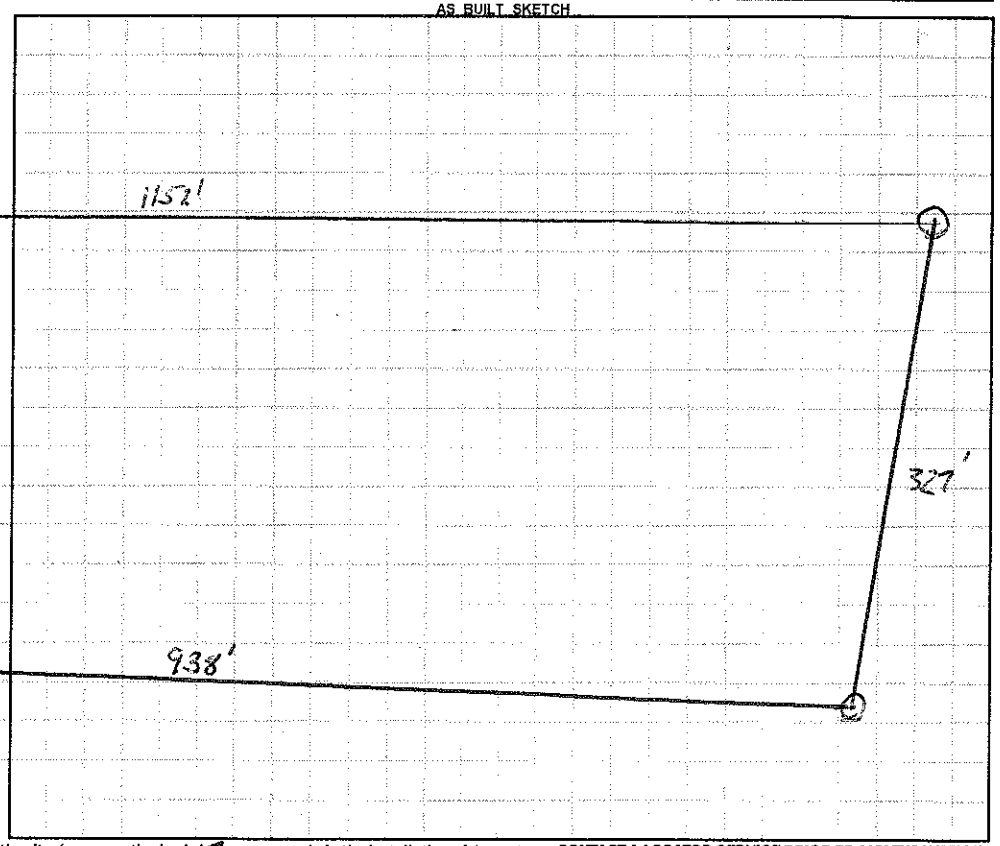

Permit can be suspended or revoked if any false information is supplied toward securing the permit / any unauthorized changes are made to the site / any unauthorized changes are made in the installation of the system. **CONTACT A LOCATOR SERVICE PRIOR TO ANY EXCAVATION**

☒ **IMPROVEMENT PERMIT** *with plat valid without expiration.* ☒ **IMPROVEMENT PERMIT** *with site plan valid for 60 mos.* ☐ **AUTHORIZATION TO CONSTRUCT** *valid for period equal to IMPROVEMENT PERMIT--not to exceed 60 mo.*

Owner / Applicant Signature: Date: Installed by: TOMMY FRYE

IMPROVEMENT PERMIT by: Date: 4-4-13 OPERATION PERMIT by: Kimberley Meemore, REHS Date: 9-4-13

AUTHORIZATION TO CONSTRUCT by: Date: 4-4-13 Existing System Inspected by: Date:

Health Dept. Copy - WHITE Applicant (Final Approval) - YELLOW Applicant (Conditional Approval) - PINK