IREDELL COUNTY HEALTH DEPARTMENT

STATESVILLE 704-878-5305 (C1) MOORESVILLE 704-664-5281

IMPROVEMENT PERMIT / AUTHORIZATION TO CONSTRUCT / OPERATION PERMIT / EXISTING SYSTEM INSPECTION

PERMIT# 092071 PIN# ~~4702 89 5559 (PT)~~ 4702-89-~~1659~~ 1743 DATE 5-25-02

OWNER OR CONTRACTOR CLAUDETTE BALLARD PHONE: Business 704-450-1088 Home 704-878-6772

ADDRESS 2032 HAZELWOOD DRIVE STATESVILLE NC 28625

LOCATION I-40 W, TL OLD MTN. RD, TR LEWIS FERRY RD, TL PINEDELL, TR SEBASTIAN LN, LOT AT END OF CUL-DE-SAC

SUBDIVISION JEFFERSON LANDING BLOCK / SECTION ____ LOT 22 (") LOT AREA 0.921 ACRE SITE CLASS. PS DESIGN FLOW 360 L.T.A.R. 0.30 GPD/FT²

Septic Tank: 1000 Gallons; STB 794 Date 2-14-03
Pump Tank: ____ Gallons; PT ____ Date ____
Pump Make: ____ Model ____ Serial No. ____
Nitrification Field: No Fields 1 Square Feet 1200 Linear Feet 400
No Lines FOUR Trench Width 36" Max Trench Bottom Depth 36" Gravel Depth 12"

☑ New System ☐ Repair System Type: I, II, III, IV, V, VI
System Description: ~~CONVENTIONAL~~ GRAVITY
Repair System Description: CONV, ~~REDUCTION~~ PUMP
Maintenance Agreement Required: ☐ Yes ☑ No

☐ House/Mod. Home ☑ Mobile Home ☐ Business ☐ Other
No. Bedrooms 3 No. Bathrooms 2 No. Employees ____


☐ Slab ☑ Crawl Space ☐ Basement w/plumbing ☐ Basement wo/plumbing

Water Supply: ☐ Individual ☑ Public ☐ Community


Comments/Conditions: OLD LOT # 11, NEW LOT # 22

Comments/Conditions: SYSTEM ALTERED AS SHOWN BELOW WITH PRIOR H.D. APPROVAL

INITIAL SITE SKETCH

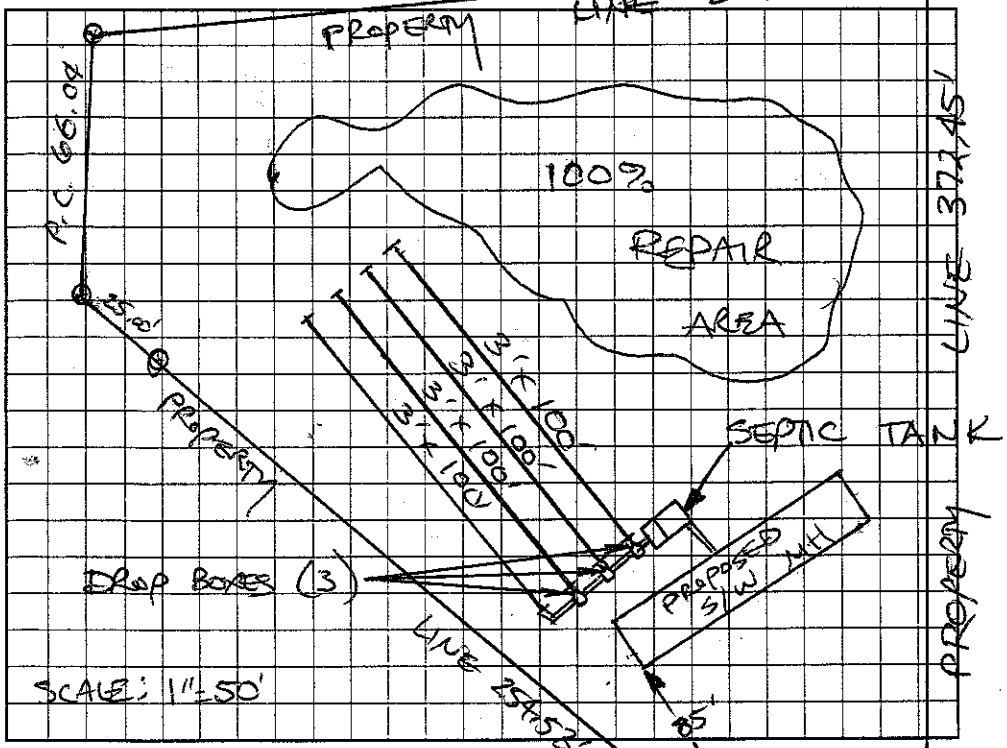

AS BUILT SKETCH

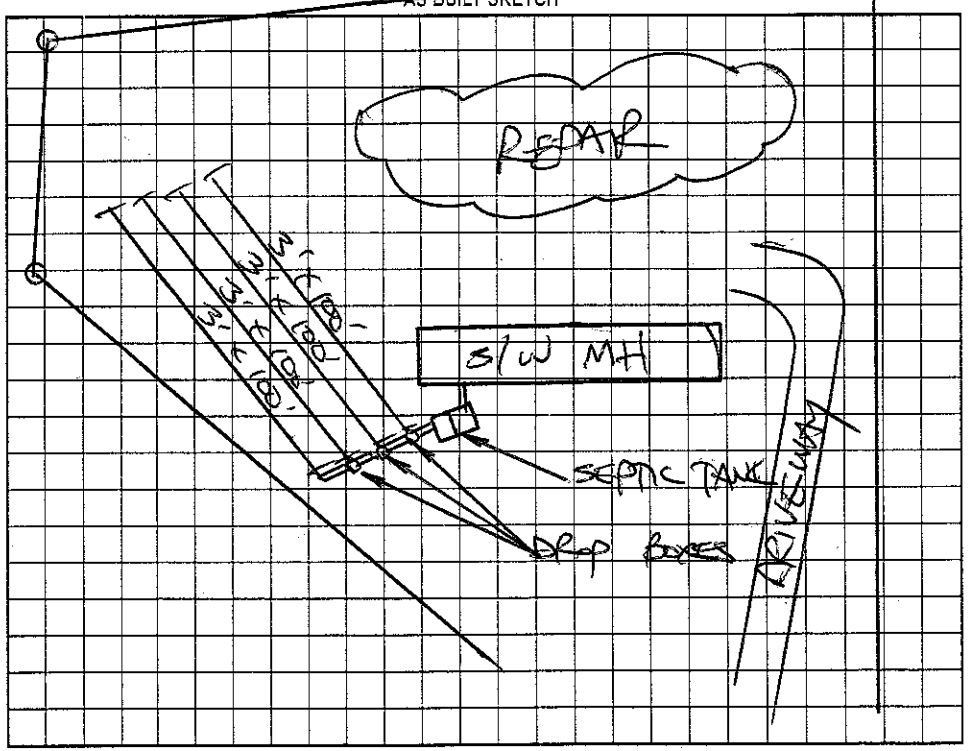

Permit can be suspended or revoked if any false information is supplied toward securing the permit/any unauthorized changes are made to the site/any unauthorized changes are made in the installation of the system. Improvement Permit with plat valid without expiration. Improvement Permit with site plan valid for sixty months. Authorization to Construct is valid for a period equal to that of Improvement Permit – not to exceed sixty months.

Signed: Claudette Ballard date 5-31-02 Installed by: KENNY MADISON

Improvement Permit by: STEVE HEDRICK date 5-25-02 Operation Permit by: STEVE HEDRICK date 7-29-03

Authorization to Construct by: STEVE HEDRICK date 5-25-02 Existing System Inspection by: ____ date ____

HEALTH DEPT. COPY: WHITE OWNER COPY (FINAL): YELLOW OWNER COPY (INITIAL): PINK