IREDELL COUNTY HEALTH DEPARTMENT

STATESVILLE 704-878-5305 (C1) MOORESVILLE 704-664-5281

IMPROVEMENT PERMIT / AUTHORIZATION TO CONSTRUCT / OPERATION PERMIT / EXISTING SYSTEM INSPECTION

PERMIT# ~~0920731161~~73 PIN# ~~4702 89 5559 (PART)~~ 4702-89-4822 DATE 11-7-00

OWNER OR CONTRACTOR CLAUDETTE BALLARD PHONE: Business 450-1088 Home 878-6772

ADDRESS 2032 HAZELWOOD DRIVE, STATESVILLE, NC 28625

LOCATION I-40 W, OLD MTN. RD, TR LEWIS FERRY RD, TL PINEDELL ACRES, TR SEBASTIAN LANE, LOTS 13 & 14 AT END ON RIGHT

SUBDIVISION JEFFERSON LANDING BLOCK / SECTION ____ LOT 13 & 14 LOT AREA 1.284 ACRES SITE CLASS. PS DESIGN FLOW 360 L.T.A.R. 0.30 GPD/FT²

Septic Tank: 1000 Gallons; STB 1012 Date 3-17-03
Pump Tank: 1000 Gallons; PT 17 Date 8-18-05
Pump Make: ~~Hydromatic~~ Myers Model ME50S-11 Serial No. ____
Nitrification Field: No Fields 1 Square Feet EQ. TO 1200 Linear Feet 200
No Lines FOUR Trench Width 24" Max Trench Bottom Depth 36" ~~Stone~~ Depth 6" SAND

☑ New System ☐ Repair System Type: I, II, (III), IV, V, VI
System Description: 50% REDUCTION PUMP
Repair System Description: 50% REDUCTION PUMP
Maintenance Agreement Required: ☐ Yes ☑ No


☐ House/Mod. Home No. Bedrooms 3
☑ Mobile Home No. Bathrooms 2
☐ Business No. Employees ____
☐ Other ____
☐ Slab ☑ Crawl Space ☐ Basement w/plumbing ☐ Basement wo/plumbing

Water Supply: ☐ Individual ☑ Public ☐ Community

Comments/Conditions: ① INSTALL SUBSURFACE INTERCEPT DRAINAGE DITCH 48" DEEP TO DAYLIGHT ② INSTALL 44 PPBPS PANELS IN 4 EQUAL LENGTH LINES ③ SEE ATTACHED SHEETS FOR PUMP AND PRESSURE MANIFOLD REQUIREMENTS.

Comments/Conditions: ① SEPTIC TANK WITH MARKER INSTALLED ② USING "TUFFITE" FILTER ③ TANKS & LINES INSPECTED 10-1-03, OK-RSH. FRENCH DRAIN INSPECTED 10-1-03 OK-RSH.

INITIAL SITE SKETCH

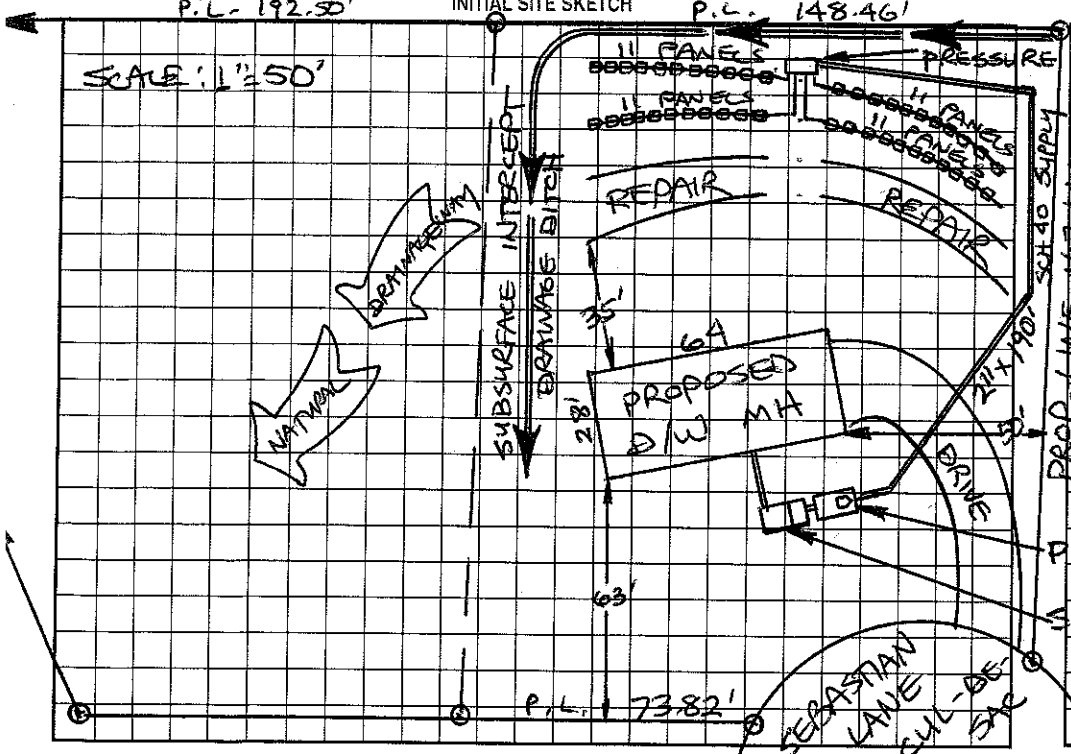

AS BUILT SKETCH

SYSTEM INSTALLED ACCORDING TO INITIAL SITE SKETCH

Permit can be suspended or revoked if any false information is supplied toward securing the permit/any unauthorized changes are made to the site/any unauthorized changes are made in the installation of the system. Improvement Permit with plat valid without expiration. Improvement Permit with site plan valid for sixty months. Authorization to Construct is valid for a period equal to that of Improvement Permit – not to exceed sixty months.

Signed: Claudette Ballard date 11-9-00
Improvement Permit by: STEVE HEDRICK date 11-7-00
Authorization to Construct by: STEVE HEDRICK date 11-7-00

Installed by: CRAIG THOMPSON
Operation Permit by: STEVE HEDRICK date 10-24-03
Existing System Inspection by: ____ date ____

HEALTH DEPT. COPY: WHITE OWNER COPY (FINAL): YELLOW OWNER COPY (INITIAL): PINK