IREDELL COUNTY HEALTH DEPARTMENT

STATESVILLE 704-878-5305 MOORESVILLE 704-664-5281

IMPROVEMENT PERMIT / AUTHORIZATION TO CONSTRUCT / OPERATION PERMIT / EXISTING SYSTEM INSPECTION

PERMIT# 092069 PIN# 4702 89 5559 (PT) DATE 9-30-00

OWNER OR CONTRACTOR CLAUDETTE BALLARD PHONE Business 878-6772 Home

ADDRESS 2032 HAZELWOOD DRIVE, STATESVILLE, NC 28625

LOCATION I-40 W, TL O.M.R., TR LEWIS FERRY RD, TL PINEBELL ACRES, TR SEBASTIAN LANE, 9TH LOT ON LEFT

SUBDIVISION JEFFERSON LANDING BLOCK / SECTION LOT 9 LOT AREA 0.905 ACRE SITE CLASS PS DESIGN FLOW 360 L.T.A.R. 0.30 GPD/FT²

Septic Tank: 1000 Gallons; STB 1012 Date 11-10-01
Pump Tank: Gallons; PT Date
Pump Make: Model Serial No
Nitrification Field: No Fields 1 Square Feet Eq. to 1200 Linear Feet 200
No Lines SIX Trench Width 24" Max Trench Bottom Depth 36" Min Depth 6" SAND

✓ New System Repair System Type: I II III IV V VI
System Description: 50% REDUCTION GRAVITY
Repair System Description: 50% REDUCTION PUMP
Maintenance Agreement Required: Yes ✓ No


House/Mod. Home No. Bedrooms 3
✓ Mobile Home No. Bathrooms 2
Business No. Employees
Other
Slab ✓ Crawl Space Basement w/plumbing Basement wo/plumbing

Water Supply: ☐ Individual ✓ Public ☐ Community


Comments/Conditions ① INSTALL SUBSURFACE INTERCEPT DRAINAGE DITCH AS SHOWN BEGINNING 48" DEEP (AT TANK) OUT BOTH DIRECTIONS TO DAYLIGHT ② INSTALL 50% REDUCTION SYSTEM USING 46 PPBPS PANELS

Comments/Conditions SEPTIC TANK WITH MARKER INSTALLED USING "POLYLOK" FILTER

INITIAL SITE SKETCH

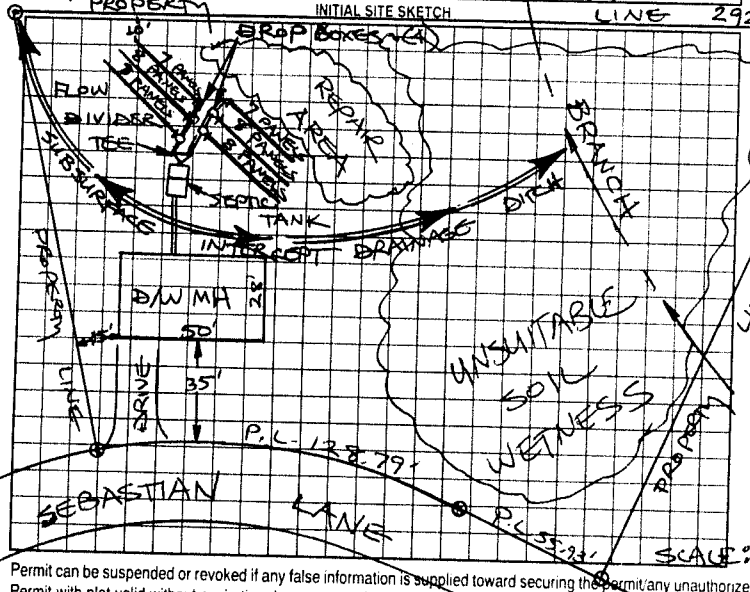

AS BUILT SKETCH

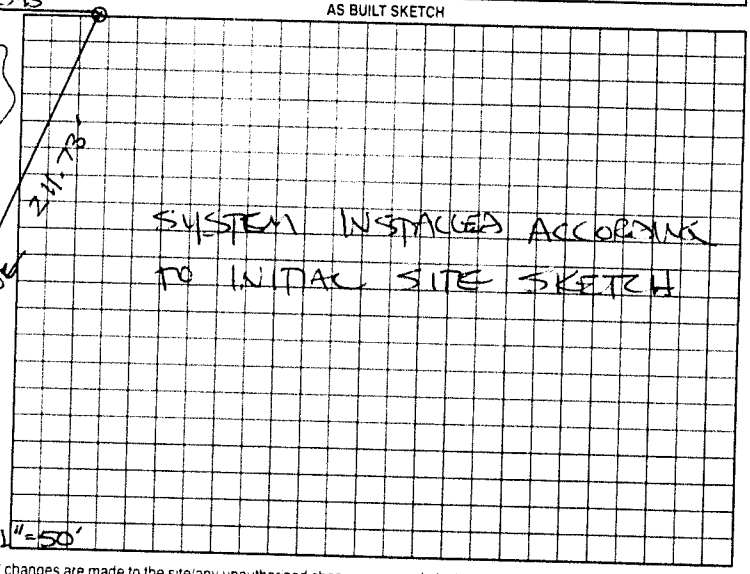

Permit can be suspended or revoked if any false information is supplied toward securing the permit/any unauthorized changes are made to the site/any unauthorized changes are made in the installation of the system. Improvement Permit with plat valid without expiration. Improvement Permit with site plan valid for sixty months. Authorization to Construct is valid for a period equal to that of Improvement Permit - not to exceed sixty months.

Signed: Claudette Ballard date 10-3-2002 Installed by: CRAIG THOMPSON

Improvement Permit by: STEVE HEDRICK date 9-30-00 Operation Permit by: STEVE HEDRICK date 4-10-02

Authorization to Construct by: STEVE HEDRICK date 9-30-00 Existing System Inspection by: date

HEALTH DEPT COPY WHITE OWNER COPY (FINAL) YELLOW OWNER COPY (INITIAL) PINK