THIS PERMIT VOIDS PREVIOUS ISSUED 10-7-00

IREDELL COUNTY HEALTH DEPARTMENT

STATESVILLE 704-878-5305 (C) MOORESVILLE 704-664-5281

IMPROVEMENT PERMIT / AUTHORIZATION TO CONSTRUCT / OPERATION PERMIT / EXISTING SYSTEM INSPECTION

PERMIT# 092062 PIN# 4702-89-7423 / 8495 DATE 5-1-02

OWNER OR CONTRACTOR LAURA & MACK HOLBROOK PHONE: Business % 704-450-1088 Home % 704-878-6772

ADDRESS 164 ANKDALE DR, STATESVILLE, NC 28677

LOCATION I-40 W, TL O.M.R., TR LEWIS FERRY RD, TL PINEDELL ACRES DR, TR SEBASTIAN LANE, 7 18TH LOTS, ON LEFT

SUBDIVISION JEFFERSON LANDING BLOCK / SECTION ____ LOT 7 & 8 LOT AREA 1.62 ACRES SITE CLASS PS DESIGN FLOW 360 L.T.A.R. 0.30 GPD/FT²

Septic Tank: 1000 Gallons: STB 794 Date 5-7-02
Pump Tank: ____ Gallons: PT ____ Date ____
Pump Make: ____ Model ____ Serial No ____
Nitrification Field: No Fields 1 Square Feet 1200 Linear Feet 400
No Lines SIX Trench Width 36" Max Trench Bottom Depth 36" Gravel Depth 12"

☑ New System ☐ Repair System Type: I II III IV V VI
System Description: CONVENTIONAL GRAVITY
Repair System Description: 25% REDUCTION, PUMP
Maintenance Agreement Required: ☐ Yes ☑ No

☐ House/Mod. Home No. Bedrooms 3
☑ Mobile Home No. Bathrooms 2
☐ Business No. Employees ____
☐ Other ____


☐ Slab ☑ Crawl Space ☐ Basement w/plumbing ☐ Basement wo/plumbing

Water Supply: ☐ Individual ☑ Public ☐ Community


Comments:/Conditions:

Comments:/Condition: SEPTIC TANK WITH MARKER. INSTALLED USING "ZABEL" FILTER

INITIAL SITE SKETCH

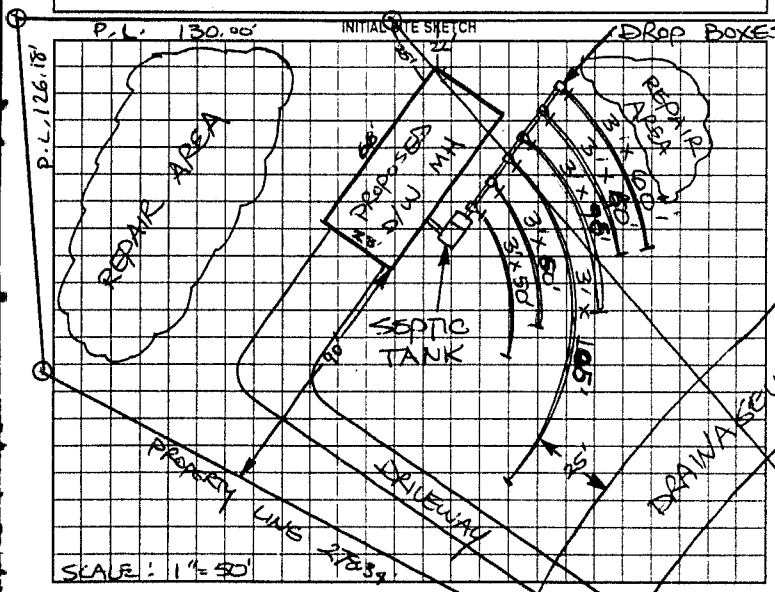

AS BUILT SKETCH

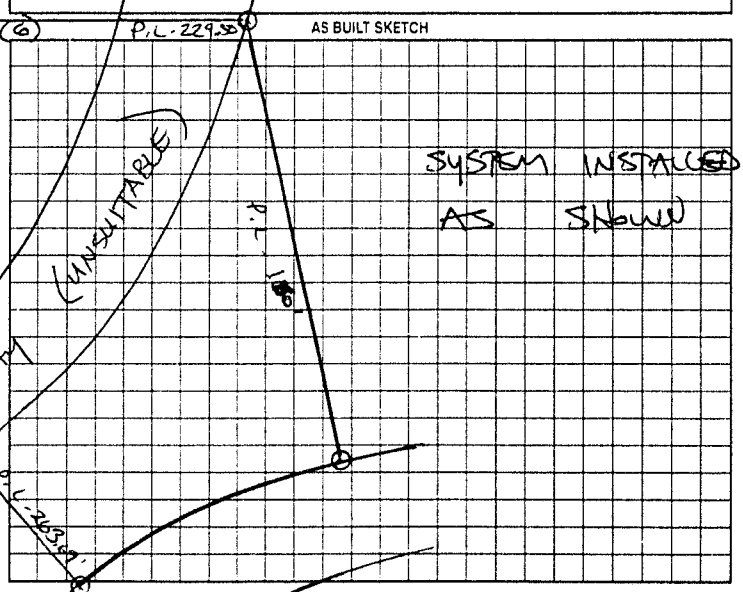

Permit can be suspended or revoked if any false information is supplied toward securing the permit, any unauthorized changes are made to the site, any unauthorized changes are made in the installation of the system. Improvement Permit with plat valid without expiration. Improvement Permit with site plan valid for sixty months. Authorization to Construct is valid for a period equal to that of Improvement Permit – not to exceed sixty months

Signed: Claudette Ballard date ____ Installed by MADISON GRADING

Improvement Permit by: STEVE HEDRICK date 5-1-02 Operation Permit by: STEVE HEDRICK date 6-26-02

Authorization to Construct by: STEVE HEDRICK date 5-7-02 Existing System Inspection by: ____ date ____

HEALTH DEPT COPY WHITE OWNER COPY (FINAL) YELLOW OWNER COPY (INITIAL) PINK