(11:00-11:30)

IREDELL COUNTY HEALTH DEPARTMENT

STATESVILLE 704-878-5305 MOORESVILLE 704-664-5281

IMPROVEMENT PERMIT / AUTHORIZATION TO CONSTRUCT / OPERATION PERMIT / EXISTING SYSTEM INSPECTION

PERMIT# 091599 PIN# 4702 89 5559 (PT) DATE 9-30-00

OWNER OR CONTRACTOR CLAUDETTE BALLARD PHONE: Business 878-6772 Home

ADDRESS 2032 HAZELWOOD DR, STATESVILLE, NC 28625

LOCATION I-40 W, TL O.M.R., TR LEWIS FERRY ROAD, TL PINEDELL ACRES, TR SEBASTIAN LANE, 4TH LOT ON LEFT

SUBDIVISION JEFFERSON LANDING BLOCK / SECTION LOT 4 LOT AREA 0.506 ACRE SITE CLASS PS1 DESIGN FLOW 360 L.T.A.R. 0.30 GPD/FT2

Septic Tank: 1060 Gallons: STB 620 Date 10-6-00
Pump Tank: Gallons: PT Date
Pump Make: Model Serial No.
Nitrification Field: No Fields 1 Square Feet 1200 Linear Feet 300 ft
No Lines FOUR Trench Width 36" Max Trench Bottom Depth 36" Depth SAND 6"

✓ New System ☐ Repair System Type: I. II (III) IV. V. VI
System Description: 25% REDUCTION GRAVITY
Repair System Description: 50% REDUCTION PUMP
Maintenance Agreement Required: ☐ Yes ✓ No
☐ Slab ✓ Crawl Space ☐ Basement w/plumbing ☐ Basement wo/plumbing


☐ House/Mod. Home No. Bedrooms 3
✓ Mobile Home No. Bathrooms 2
☐ Business No. Employees
☐ Other

Water Supply: ☐ Individual ✓ Public ☐ Community

Comments/Conditions: ① INSTALL SUBSURFACE INTERCEPT DRAINAGE DITCH AS SHOWN BEGINNING 48" INCHES DEEP ② INSTALL 25% REDUCTION SYSTEM USING 50 CHAMBERS OR THIRTY (30) HDS SECTIONS.

Comments/Conditions: poly lock filter installed

INITIAL SITE SKETCH

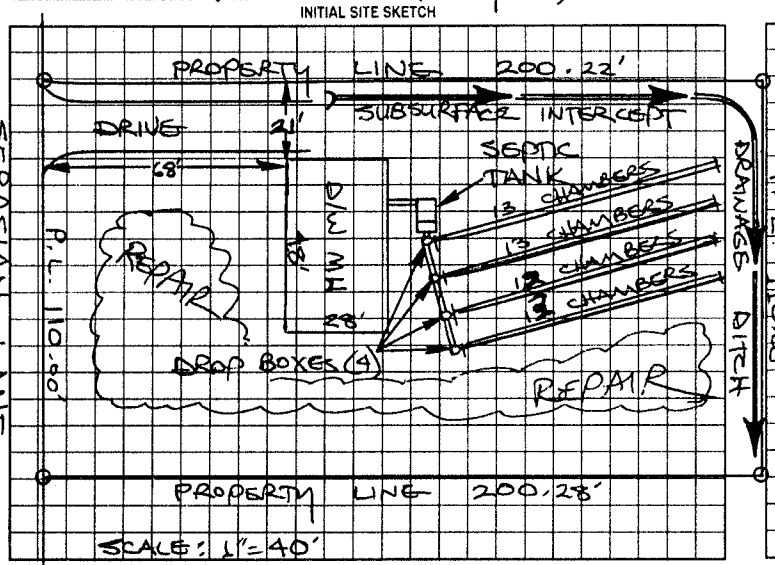

AS BUILT SKETCH

Installed as shown

Permit can be suspended or revoked if any false information is supplied toward securing the permit/any unauthorized changes are made to the site/any unauthorized changes are made in the installation of the system. Improvement Permit with plat valid without expiration. Improvement Permit with site plan valid for sixty months. Authorization to Construct is valid for a period equal to that of Improvement Permit – not to exceed sixty months.

Signed: Claudette Ballard date 10/3-2000 Installed by: KENNY MADISON

Improvement Permit by: STEVE HEDRICK date 9-30-00 Operation Permit by: STEVE HEDRICK date 12-29-00

Authorization to Construct by: STEVE HEDRICK date 9-30-00 Existing System Inspection by: date

HEALTH DEPT COPY: WHITE OWNER COPY (FINAL): YELLOW OWNER COPY (INITIAL): PINK