IREDELL COUNTY HEALTH DEPARTMENT

STATESVILLE 704-878-5305 MOORESVILLE 704-664-5281

IMPROVEMENT PERMIT / AUTHORIZATION TO CONSTRUCT / OPERATION PERMIT / EXISTING SYSTEM INSPECTION

PERMIT# 91245 PIN# 4702895559 DATE 10/3/00

OWNER OR CONTRACTOR CLAUDETTE BALLARD PHONE: Business 871-0091 Home

ADDRESS 195 PLEASANT DR. STATESVILLE 28677

LOCATION OLD MT RD- TL LEWIS FERRY - TL PINEDELL AC - TR JEFFERSON - ON LT

SUBDIVISION JEFFSON LANDING BLOCK / SECTION LOT 3 LOT AREA .5 AC SITE CLASS RS DESIGN FLOW 360 GPD L.T.A.R. .39 gal/ft2

Septic Tank: 1000 Gallons; STB 6 20/98 Date 8/13/00
Pump Tank: Gallons; PT Date
Pump Make: Model Serial No.
Nitrification Field: No Fields 1 Square Feet @ 110 Linear Feet 370
No Lines 5 Trench Width 36" Max Trench Bottom Depth 24" Gravel Depth N/A

☑ New System ☐ Repair System Type: I. II (III) IV. V. VI
System Description: GRAVITY 25% REDUCTION
Repair System Description: SAME
Maintenance Agreement Required: ☐ Yes ☑ No


☑ House/Mod. Home No. Bedrooms 3
☐ Mobile Home No. Bathrooms 2
☐ Business No. Employees
☐ Other
☐ Slab ☑ Crawl Space ☐ Basement w/plumbing ☐ Basement wo/plumbing

Water Supply: ☐ Individual ☑ Public ☐ Community

Comments/Conditions:

Comments/Conditions:

INITIAL SITE SKETCH 1"=40'

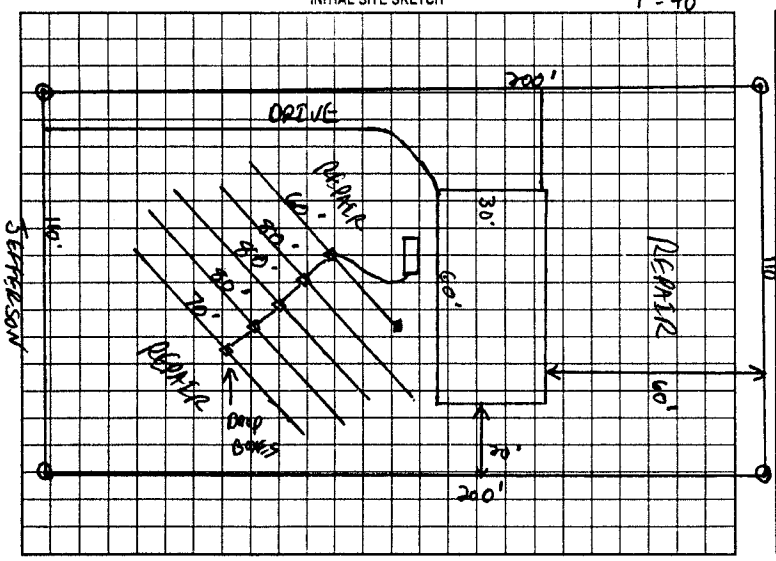

AS BUILT SKETCH

Permit can be suspended or revoked if any false information is supplied toward securing the permit/any unauthorized changes are made to the site/any unauthorized changes are made in the installation of the system. Improvement Permit with plat valid without expiration. Improvement Permit with site plan valid for sixty months. Authorization to Construct is valid for a period equal to that of Improvement Permit – not to exceed sixty months.

Signed: Claudette Ballard date 10/3/2000 Installed by: KENNY MADISON

Improvement Permit by: [signature] RS date 10/3/00 Operation Permit by: [signature] RS date 10/13/00

Authorization to Construct by: [signature] RS date 10/3/00 Existing System Inspection by: date

HEALTH DEPT. COPY WHITE OWNER COPY (FINAL) YELLOW OWNER COPY (INITIAL) PINK