pd 125 11-19-97

IREDELL COUNTY HEALTH DEPARTMENT

STATESVILLE 704-878-5305 MOORESVILLE 704-664-5281

IMPROVEMENT PERMIT / CERTIFICATE OF COMPLETION / OPERATION PERMIT / EXISTING SYSTEM INSPECTION

PROPERTY DESCRIPTION NO. 69247 DATE 9-20-97 TAX MAP NO. 4702943542 Watershed: ☐ Yes ☐ No WS-IV PA

OWNER OR CONTRACTOR Sunwood Builders PHONE: Business 872 0921 Home

ADDRESS PO Box 5807 Sta.

LOCATION 70 W TL Enfield Pt TR Saunders TR Span 2nd lot Rt.

SUBDIVISION Key Acres BLOCK / SECTION 3 LOT 23 LOT AREA .53 acres SITE CLASS. PS DESIGN FLOW 360 L.T.A.R. .3

Septic Tank: 1000 Gallons; STB 1017 Date 9-24-97

Pump Tank: _____ Gallons; PT _____ Date _____

Pump Make: _____ Model _____ Serial No. _____

Nitrification Field: No Fields 1 Square Feet 900 Linear Feet 300

No Lines 3 Trench Width 36" Max Trench Bottom Depth 36" Gravel Depth N/A

☑ New System ☐ Repair System Type: I, II, III, IV, V, VI

System Description: Gravity/Chambers or HDS

Repair System Description: " "

Maintenance Agreement Required: ☐ Yes ☑ No

☐ House/Mod. Home No. Bedrooms 3

☑ Mobile Home No. Bathrooms 2

☐ Business No. Employees ____

☐ Other


☐ Slab ☑ Crawl Space ☐ Basement w/plumbing ☐ Basement wo/plumbing

Water Supply: ☑ Individual ☐ Community ☐ Public

Comments:

Comments:

INITIAL SITE SKETCH 180

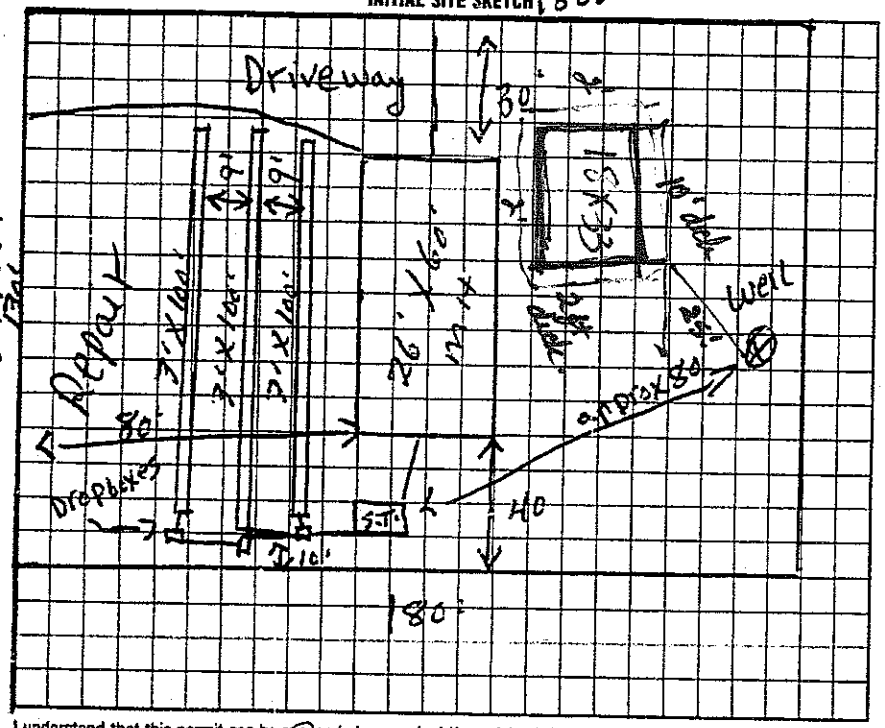

Stream

AS BUILT SKETCH

Installed as shown

Location of the proposed above ground pool addition does not appear to impact the existing on-site septic system.**NOTE:

Date: 5-16-11 REHS

ICHD-Environmental Health Division

I understand that this permit can be suspended or revoked if any false information is supplied toward securing the permit/any unauthorized changes are made to the site/any unauthorized changes are made in the installation of the system. Improvement Permit is valid for 60 months from date of issuance.

Signed: _____

Improvement Permit by: R. C. Moore date 9-20-97

Authorization to Existing System Inspection R. C. Moore date 9-20-97

to Court.

Installed by: Tommy Frye

Certificate of Completion by: _____ date _____

Operation Permit by: _____ date 3-23-98

HEALTH DEPT. COPY: WHITE INSPECTION COPY (FINAL): GREEN OWNER COPY (FINAL): YELLOW INSPECTION COPY (INITIAL): PINK OWNER COPY (INITIAL): GOLD

Authorization to court. Expires 60 mos from issue