IREDELL COUNTY HEALTH DEPARTMENT

STATESVILLE 704-878-5305 MOORESVILLE 704-664-5281

IMPROVEMENT PERMIT / CERTIFICATE OF COMPLETION / OPERATION PERMIT / EXISTING SYSTEM INSPECTION

PROPERTY DESCRIPTION NO. 69246 DATE 9-13-97 TAX MAP NO. 4706294 3542 Watershed: ☐ Yes ☐ No

OWNER OR CONTRACTOR Sun Wood Builders PHONE: Business 872 0921 Home

ADDRESS PO Box 5811 Statesville

LOCATION 70 W TO Eufola RD TR Pounders Ridge on Rt

SUBDIVISION Key Acres BLOCK / SECTION LOT 22 LOT AREA 1.55 acres SITE CLASS. PS DESIGN FLOW 360 L.T.A.R. .13

Septic Tank: 1000 Gallons; STB 1007 Date 8-16-99

Pump Tank: Gallons; PT Date

Pump Make: Model Serial No.

Nitrification Field: No Fields 1 Square Feet 900 Linear Feet 300

No Lines 4 Trench Width 36" Max Trench Bottom Depth 36" Gravel Depth N/A

☒ New System ☐ Repair System Type: I, II, III, IV, V, VI

System Description: Gravity Chambers

Repair System Description: 11 12 or HS

Maintenance Agreement Required: ☐ Yes ☒ No

☐ House/Mod. Home ☒ Mobile Home ☐ Business ☐ Other

No. Bedrooms 3 No. Bathrooms 2 No. Employees


☐ Slab ☒ Crawl Space ☐ Basement w/plumbing ☐ Basement wo/plumbing

Water Supply: ☒ Individual ☐ Community ☐ Public


Comments:

Comments:

INITIAL SITE SKETCH 200'

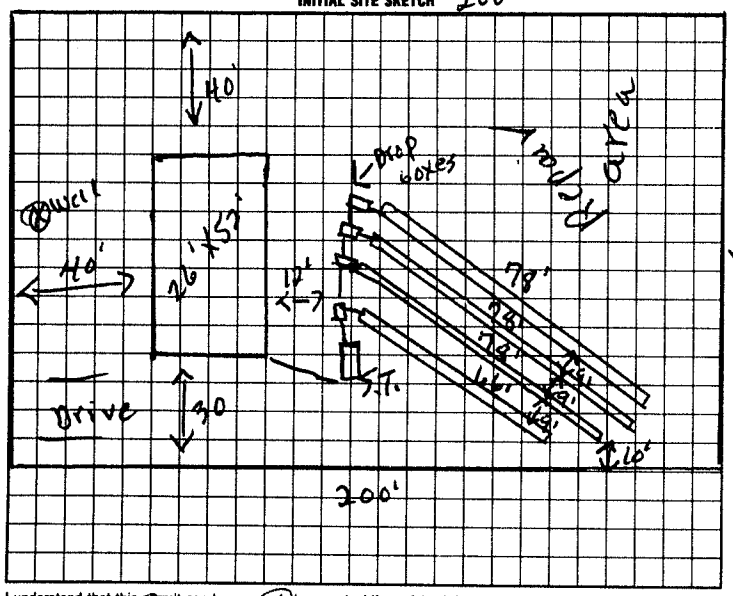

AS BUILT SKETCH

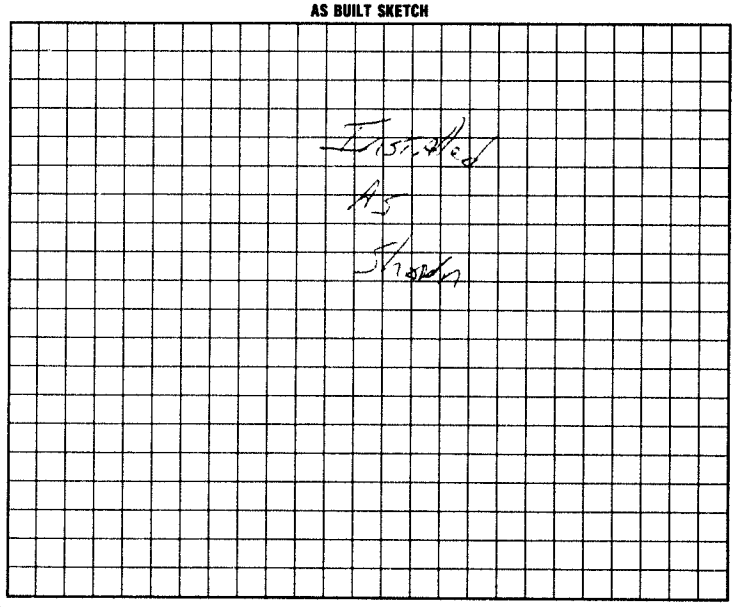

I understand that this permit can be suspended or revoked if any false information is supplied toward securing the permit/any unauthorized changes are made to the site/any unauthorized changes are made in the installation of the system. Improvement Permit is valid for 60 months from date of issuance.

Signed: Tony Jenkins

Improvement Permit by: P.C. Moore date 9-13-97

Existing System Inspection by: P.C. Moore date 9-13-97

to Court.

Installed by: Tommy Co. Thrash

Certificate of Completion by: [illegible] date 9-23-97

Operation Permit by: date

TO HEALTH DEPT. COPY: WHITE INSPECTION COPY (FINAL): GREEN OWNER COPY (FINAL): YELLOW INSPECTION COPY (INITIAL): PINK OWNER COPY (INITIAL): GOLD

Authorization to court. Expires 60 mos from issue