IREDELL COUNTY HEALTH DEPARTMENT

STATESVILLE 704-878-5305 MOORESVILLE 704-664-5281

IMPROVEMENT PERMIT / CERTIFICATE OF COMPLETION / OPERATION PERMIT / EXISTING SYSTEM INSPECTION

PROPERTY DESCRIPTION NO. 65877 DATE 6-14-97

OWNER OR CONTRACTOR Sunwood Builders TAX MAP NO. 4702 94 3542

ADDRESS PO Box 5800 PHONE: Business 704 872 0922 Home Watershed: ☐ Yes ☐ No

LOCATION Now Tl Eufola Rd Star on Rt before Celeste Eufola Rd

SUBDIVISION Key Acres BLOCK / SECTION II LOT 14 LOT AREA 120' X 206' SITE CLASS: PS DESIGN FLOW 360 L.T.A.R. 13

Septic Tank: 1060 Gallons; STB 1512 Date 6-2-97

Pump Tank: Gallons; PT Date

Pump Make: Model Serial No.

Nitrification Field: No Fields 1 Square Feet 1200 Linear Feet 400

No Lines 4 Trench Width 36" Max Trench Bottom Depth 36" Gravel Depth 12"

☐ New System ☐ Repair System Type: I, II, III, IV, V, VI

System Description: Conv. Gravity

Repair System Description: Gravity Chambers

Maintenance Agreement Required: ☐ Yes ☑ No

☑ House/Mod. Home ☑ Mobile Home ☐ Business ☐ Other

No. Bedrooms 3 No. Bathrooms 2 No. Employees


☐ Slab ☑ Crawl Space ☐ Basement w/plumbing ☐ Basement wo/plumbing

Water Supply: ☑ Individual ☐ Community ☐ Public


Comments:

Comments:

INITIAL SITE SKETCH

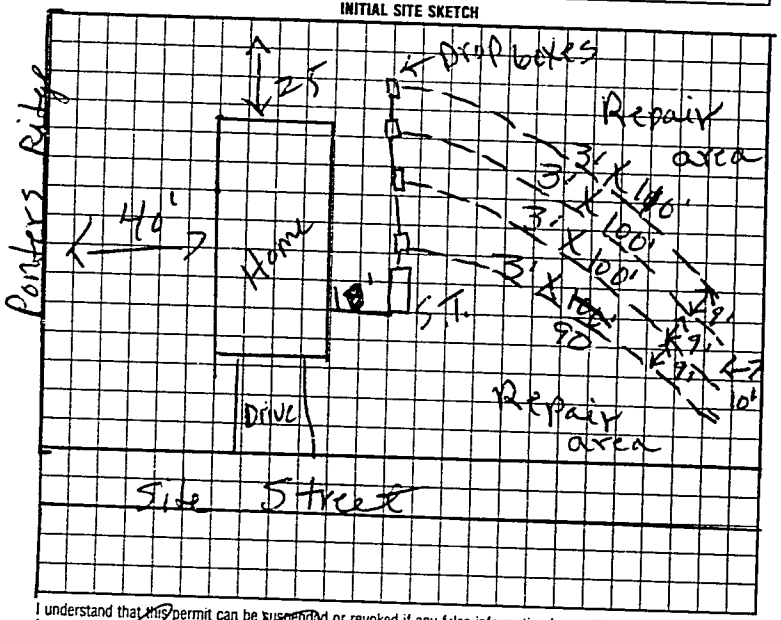

AS BUILT SKETCH

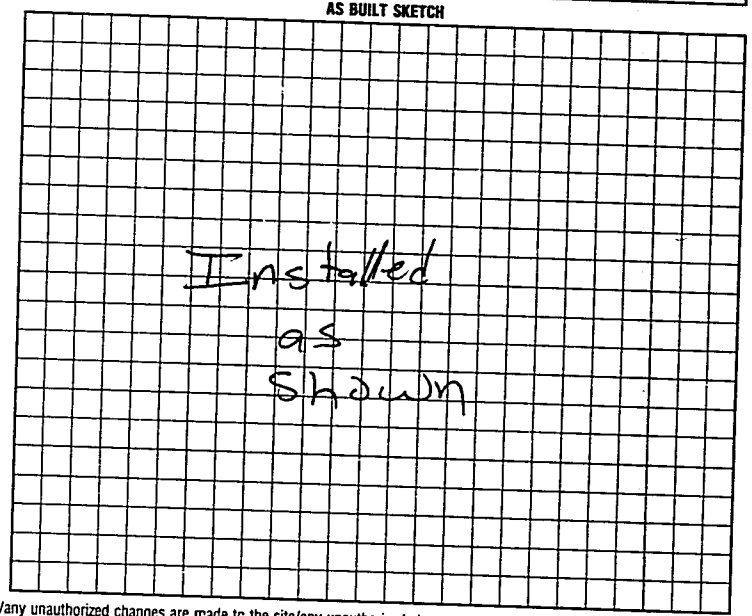

I understand that this permit can be suspended or revoked if any false information is supplied toward securing the permit/any unauthorized changes are made to the site/any unauthorized changes are made in the installation of the system. Improvement Permit is valid for 60 months from date of issuance.

Signed:

Improvement Permit by: L.C. Moore date 6-14-97

Authorization to Construct Existing System Inspection by: L.C. Moore date 6-14-97

Installed by: Tommy Frye

Certificate of Completion by: date

Operation Permit by: Mark C. Ostrus date 8-11-97

HEALTH DEPT. COPY WHITE INSPECTION COPY (FINAL) GREEN OWNER COPY (FINAL) YELLOW INSPECTION COPY (INITIAL) PINK OWNER COPY (INITIAL) GOLD

Authorization to Const EXPIRES 60 mon from issue

8 2 8 2 0 0