IREDELL COUNTY HEALTH DEPARTMENT

STATESVILLE 704-878-5305 MOORESVILLE 704-664-5281

IMPROVEMENT PERMIT / CERTIFICATE OF COMPLETION / OPERATION PERMIT / EXISTING SYSTEM INSPECTION

PROPERTY DESCRIPTION NO. 65874 DATE 6-14-97 TAX MAP NO. 4702943542 Watershed: ☑ Yes ☐ No

OWNER OR CONTRACTOR Sunwood Builders PHONE: Business 704 872 0922 Home

ADDRESS PO Box 5370 Statesville

LOCATION 70W TL Eufola Rd on rt before Celeste Eufola Rd

SUBDIVISION Keyacres BLOCK / SECTION II LOT 11 LOT AREA 1.71 acres SITE CLASS. PS DESIGN FLOW 360 L.T.A.R. 13

Septic Tank: 1000 Gallons; STB 100 Date 7-23-97

Pump Tank: Gallons; PT Date

Pump Make: Model Serial No.

Nitrification Field: No Fields 1 Square Feet 1200 Linear Feet 400

No Lines 4 Trench Width 36" Max Trench Bottom Depth 36" Gravel Depth 12"

☑ New System ☐ Repair System Type: I, II, III, IV, V, VI

System Description: Conv. Gravity

Repair System Description:

Maintenance Agreement Required: ☐ Yes ☑ No

☐ House/Mod. Home No. Bedrooms 3

☑ Mobile Home No. Bathrooms 2

☐ Business No. Employees

☐ Other


☐ Slab ☑ Crawl Space ☐ Basement w/plumbing ☐ Basement wo/plumbing

Water Supply: ☑ Individual ☐ Community ☐ Public


Comments:

Comments:

INITIAL SITE SKETCH

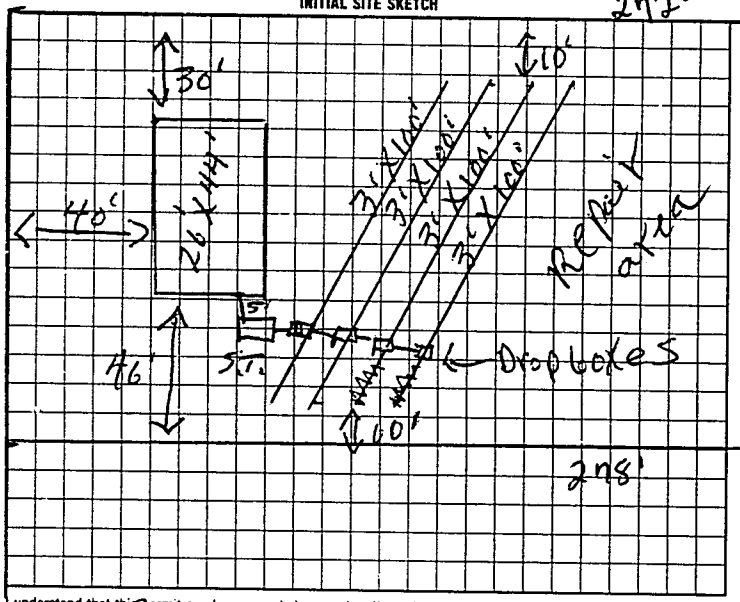

AS BUILT SKETCH

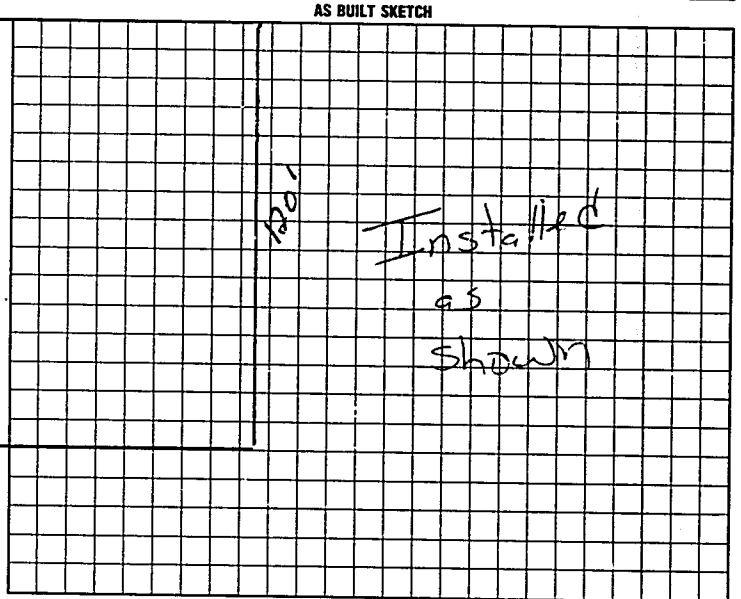

I understand that this permit can be suspended or revoked if any false information is supplied toward securing the permit/any unauthorized changes are made to the site/any unauthorized changes are made in the installation of the system. Improvement Permit is valid for 60 months from date of issuance.

Signed:

Improvement Permit by: E.C. Moore date 6-14-97

Existing System Inspection by: Authorization E.C. Moore date 6-14-97

Installed by: Tammy Fritz

Certificate of Completion by: date

Operation Permit by: Mark C Ont RS date 6-23-97

HEALTH DEPT. COPY: WHITE to court. INSPECTION COPY (FINAL): GREEN OWNER COPY (FINAL): YELLOW INSPECTION COPY (INITIAL): PINK OWNER COPY (INITIAL): GOLD

Authorization to court EXPIRES 60 months issue

1582 00