IREDELL COUNTY HEALTH DEPARTMENT

STATESVILLE 704-878-5305 MOORESVILLE 704-664-5281

IMPROVEMENT PERMIT / CERTIFICATE OF COMPLETION / OPERATION PERMIT / EXISTING SYSTEM INSPECTION

PROPERTY DESCRIPTION NO. 26346 DATE 4-2-97 TAX MAP NO. 4702-94-3542 Watershed: ☐ Yes ☐ No

OWNER OR CONTRACTOR Sunwood Builders PHONE: Business 872-0925 Home WSIV PA

ADDRESS PO BOX 5877 Sta 28687

LOCATION old mtn TR Celeste Enfola TR Enfola 1/4mi left

SUBDIVISION Key acres BLOCK / SECTION LOT 9 LOT AREA 1.527 acres SITE CLASS PS DESIGN FLOW 360 L.T.A.R. .3

Septic Tank: 1000 Gallons; STB 1012 Date 1-27-97

Pump Tank: Gallons; PT Date

Pump Make: Model Serial No.

Nitrification Field: No Fields 1 Square Feet 1200 Linear Feet 400

No Lines 4 Trench Width 36" Max Trench Bottom Depth 36" Gravel Depth 12"

☑ New System ☐ Repair System Type: I (II) III, IV, V, VI

System Description: Conv. Gravity

Repair System Description: Pump to Panels

Maintenance Agreement Required: ☐ Yes ☐ No

☐ House/Mod. Home ☑ Mobile Home ☐ Business ☐ Other

No. Bedrooms 3 No. Bathrooms 2 No. Employees


☐ Slab ☐ Crawl Space ☐ Basement w/plumbing ☐ Basement w/o plumbing

Water Supply: ☑ Individual ☐ Community ☐ Public


Comments:

Comments:

INITIAL SITE SKETCH

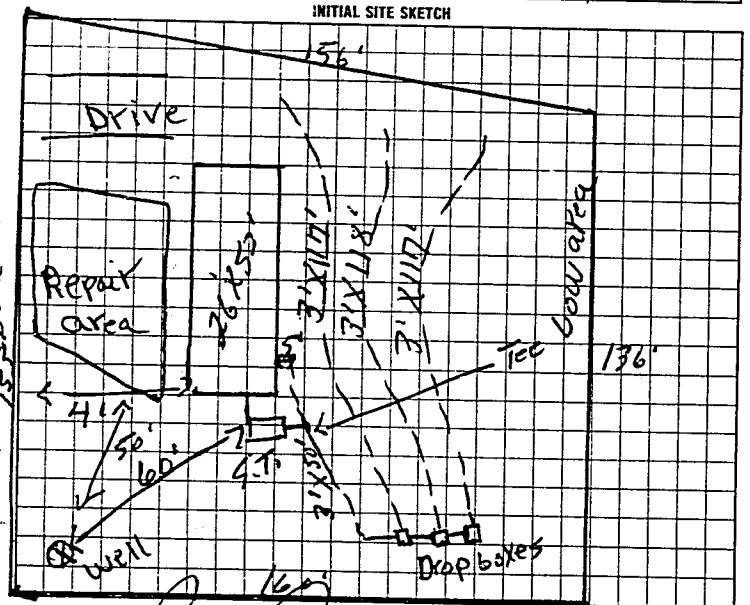

AS BUILT SKETCH

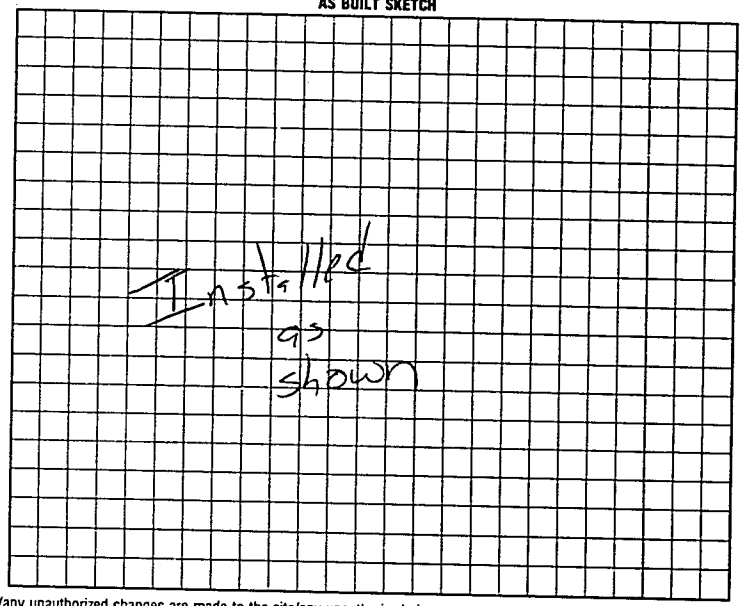

I understand that this permit can be suspended or revoked if any false information is supplied toward securing the permit/any unauthorized changes are made to the site/any unauthorized changes are made in the installation of the system. Improvement Permit is valid for 60 months from date of issuance.

Signed:

Improvement Permit by: E.C. moore date 4-2-97

Authorization to Existing System Inspection by: E.C. moore date 4-2-97

Installed by: Tommy Frye

Certificate of Completion by: date

Operation Permit by: Mat C Ortis date 4-11-97

HEALTH DEPT. COPY - WHITE INSPECTION COPY (FINAL) - GREEN OWNER COPY (FINAL) - YELLOW INSPECTION COPY (INITIAL) - PINK OWNER COPY (INITIAL) - GOLD

Authorization to Count Expires 60 mos from issue

to count!

9 2 8 2 0 0