IREDELL COUNTY HEALTH DEPARTMENT

STATESVILLE 704-878-5305 MOORESVILLE 704-664-5281

IMPROVEMENT PERMIT / AUTHORIZATION TO CONSTRUCT / OPERATION PERMIT / EXISTING SYSTEM INSPECTION

PERMIT# 69238 PIN# 4702 94 3542 DATE 2-12-98

OWNER OR CONTRACTOR Sunwood Builders PHONE: Business 704 872 0921 Home

ADDRESS PO Box 5877 Statesville

LOCATION Hickory Hwy TL Eufola Rd TR Saunders Ridge on left

SUBDIVISION Key Acres BLOCK / SECTION LOT 15 LOT AREA .73acres SITE CLASS PS DESIGN FLOW 360 L.T.A.R. .3

Septic Tank: 1000 Gallons; STB 1012 Date 9-23-97

Pump Tank: Gallons; PT Date

Pump Make: Model 966 Serial No.

Nitrification Field: No Fields 1 Square Feet Linear Feet 300

No Lines 3 Trench Width 36" Max Trench Bottom Depth 36" Gravel Depth 12"

☒ New System ☐ Repair System Type: I, II, III, IV, V, VI

System Description: Gravity chambers

Repair System Description: " " or HP

Maintenance Agreement Required: ☐ Yes ☒ No

☐ House/Mod. Home No. Bedrooms 3

☒ Mobile Home No. Bathrooms 2

☐ Business No. Employees

☐ Other


☐ Slab ☐ Crawl Space ☐ Basement w/plumbing ☐ Basement wo/plumbing

Water Supply: ☒ Individual ☐ Public ☐ Community


Comments:/Conditions: Replaces Permit issued 9-13-97

Comments:/Conditions:

INITIAL SITE SKETCH

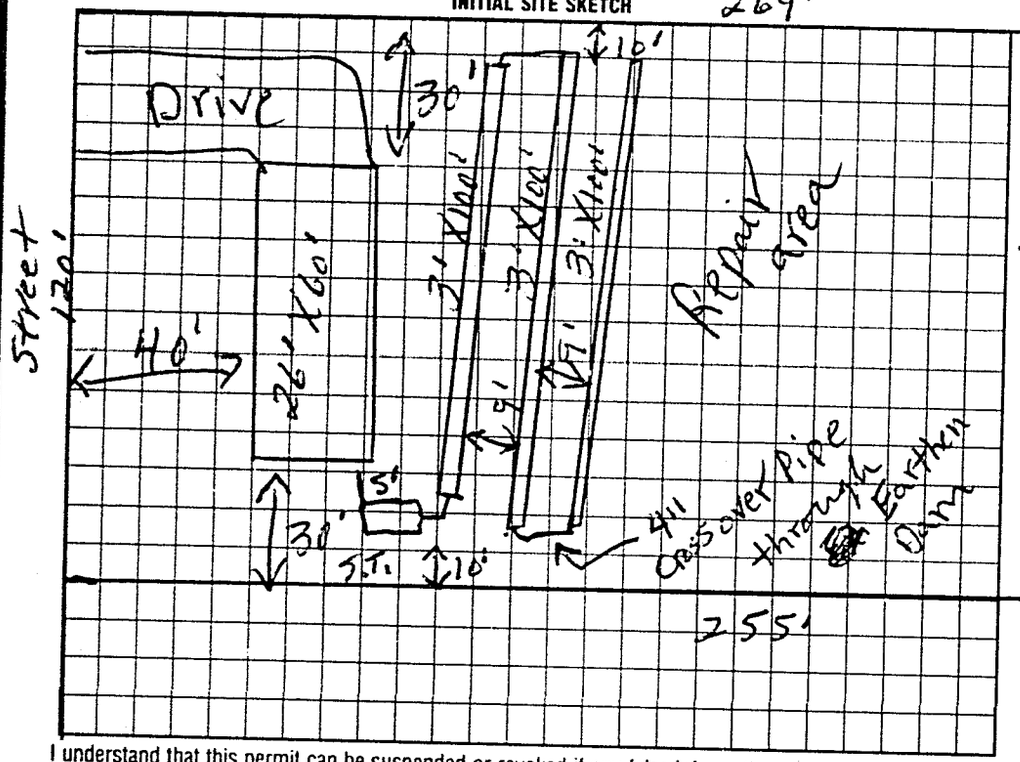

AS BUILT SKETCH

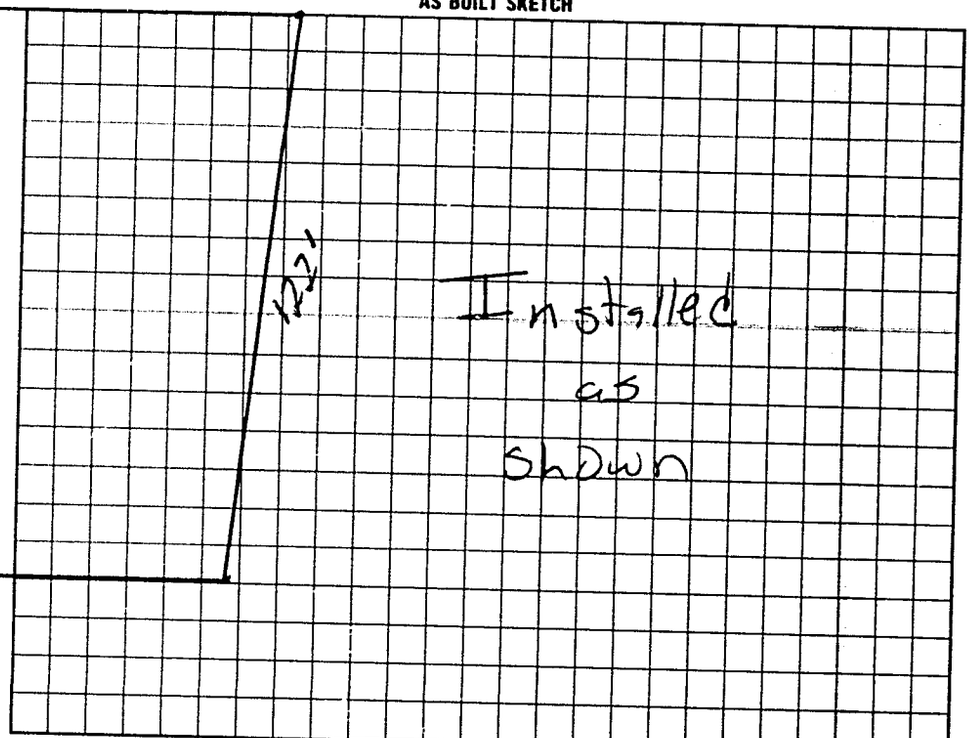

I understand that this permit can be suspended or revoked if any false information is supplied toward securing the permit/any unauthorized changes are made to the site/any unauthorized changes are made in the installation of the system. Improvement Permit with plat valid without expiration. Improvement Permit with site plan valid for sixty months. Authorization to Construct is valid for a period equal to that of Improvement Permit – not to exceed sixty months.

Signed: date

Improvement Permit by: P.C. Moore date 2-12-98

Authorization to Construct by: P.C. Moore date 2-12-98

Installed by: Tommy Frye

Operation Permit by: date

Existing System Inspection by: Mary Curtis date 2-25-98

HEALTH DEPT. COPY WHITE INSPECTION COPY (FINAL) GREEN OWNER COPY (FINAL) YELLOW INSPECTION COPY (INITIAL) PINK OWNER COPY (INITIAL): GOLD