1:00 - 1:30

IREDELL COUNTY HEALTH DEPARTMENT

STATESVILLE 704-878-5305 MOORESVILLE 704-664-5281

IMPROVEMENT PERMIT / CERTIFICATE OF COMPLETION / OPERATION PERMIT / EXISTING SYSTEM INSPECTION

PROPERTY DESCRIPTION NO. 24981 DATE 9-19-96 TAX MAP NO. 8C-B-8A Watershed: ☑ Yes ☐ No WSIV

OWNER OR CONTRACTOR Sunwood PHONE: Business 872 0922 Home

ADDRESS PO Box 5nnn Sta.

LOCATION Eufola Rd on Rt before celeste Eufola

SUBDIVISION Keydets BLOCK / SECTION LOT 6 LOT AREA 1.691 acres SITE CLASS. P3 DESIGN FLOW 360 L.T.A.R. 1.3

Septic Tank: 1000 Gallons; STB Date

Pump Tank: Gallons; PT Date

Pump Make: Model Serial No.

Nitrification Field: No Fields 1 Square Feet 900 Linear Feet 300

No Lines 3 Trench Width 36 Max Trench Bottom Depth 36 Gravel Depth N/A

☑ New System ☐ Repair System Type: I, II, III, IV, V, VI

System Description: Gravity Chambers

Repair System Description: 11 Panels

Maintenance Agreement Required: ☐ Yes ☑ No

☐ House/Mod. Home No. Bedrooms 3

☑ Mobile Home No. Bathrooms 2

☐ Business No. Employees

☐ Other


☐ Slab ☑ Crawl Space ☐ Basement w/plumbing ☐ Basement wo/plumbing

Water Supply: ☑ Individual ☐ Community ☐ Public


Comments: Split line through center

Comments: Well is 70ft from system

INITIAL SITE SKETCH

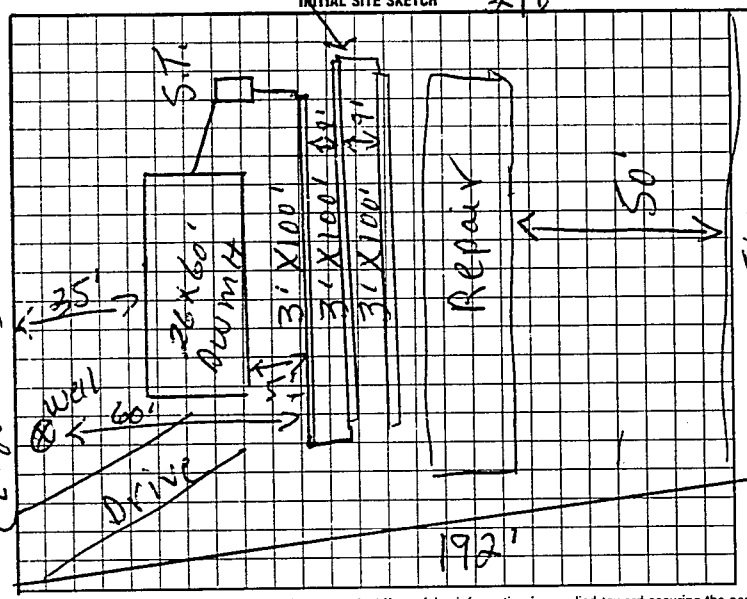

AS BUILT SKETCH

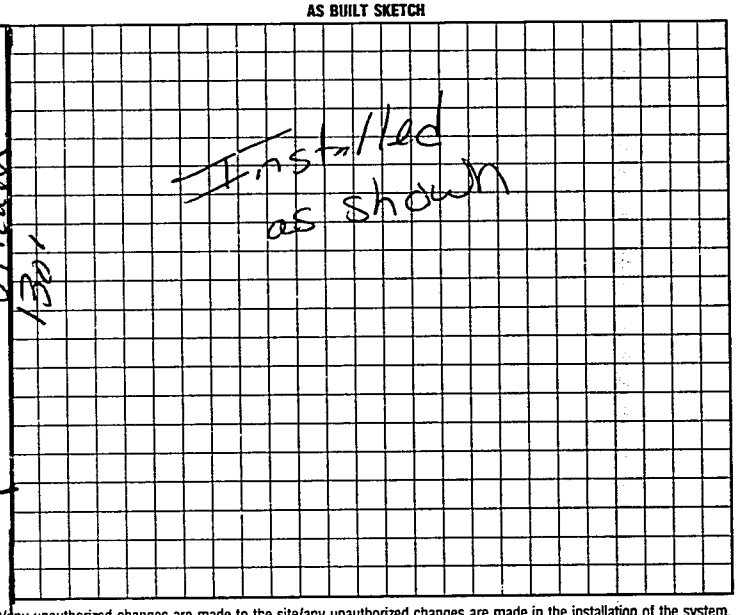

I understand that this permit can be suspended or revoked if any false information is supplied toward securing the permit/any unauthorized changes are made to the site/any unauthorized changes are made in the installation of the system.

Signed:

Improvement Permit by: E.C. Moore date 9-19-96

Authorization to Install System Inspection by: E.C. Moore date 9-19-96

Installed by: Tommy Cothren

Certificate of Completion by: date

Operation Permit by: Mark C Oakes date 2-26-97

HEALTH DEPT. COPY WHITE INSPECTION COPY (FINAL): GREEN OWNER COPY (FINAL): YELLOW INSPECTION COPY (INITIAL): PINK OWNER COPY (INITIAL): GOLD

Authorization to Install EXPIRES 60 months from issue

958200