63174

IREDELL COUNTY HEALTH DEPARTMENT

STATESVILLE 704-878-5305 MOORESVILLE 704-664-5281

IMPROVEMENT PERMIT / CERTIFICATE OF COMPLETION / OPERATION PERMIT / EXISTING SYSTEM INSPECTION

PROPERTY DESCRIPTION NO. 24985 DATE 9-17-96 TAX MAP NO. 8C-B-8A Pt 06 Watershed: ☐ Yes ☐ No

OWNER OR CONTRACTOR Sunwood Builders PHONE: Business 872 0922 Home

ADDRESS P.O. Box 5877 Statesville, N.C.

LOCATION Now TL Eufola on left before Celeste Eufola Rd

SUBDIVISION Key Acres BLOCK / SECTION LOT 2 LOT AREA 1.689 SITE CLASS PS DESIGN FLOW 360 L.T.A.R. 1.3

Septic Tank: 1000 Gallons; STB 1012 Date 5-3-96

Pump Tank: Gallons; PT Date

Pump Make: Model Serial No.

Nitrification Field: No Fields 1 Square Feet 1200 Linear Feet 400

No Lines 4 Trench Width 36" Max Trench Bottom Depth 36" Gravel Depth 12"

☑ New System ☐ Repair System Type: I (II) III, IV, V, VI

System Description: Conv. Gravity

Repair System Description: Gravity Chambers

Maintenance Agreement Required: ☐ Yes ☑ No

☐ House/Mod. Home ☑ Mobile Home ☐ Business ☐ Other

No. Bedrooms 3 No. Bathrooms 2 No. Employees


☐ Slab ☑ Crawl Space ☐ Basement w/plumbing ☐ Basement wo/plumbing

Water Supply: ☑ Individual ☐ Community ☐ Public


Comments:

Comments:

INITIAL SITE SKETCH

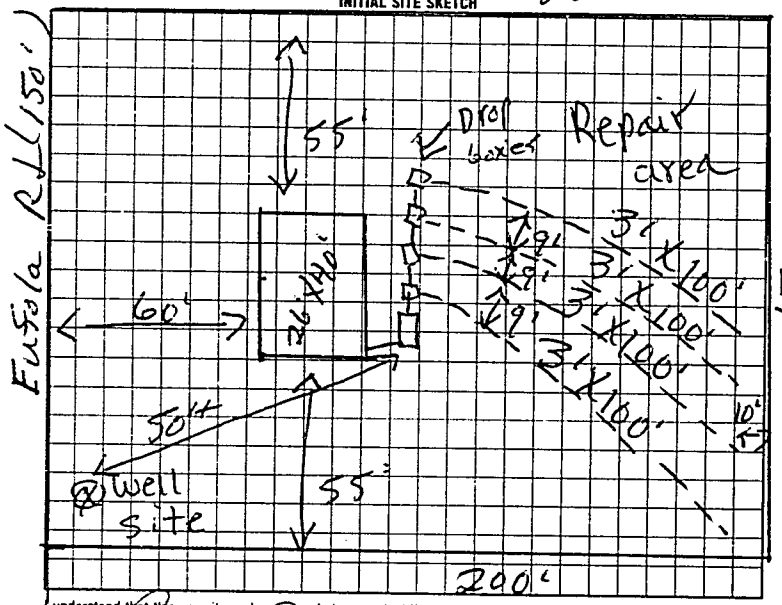

AS BUILT SKETCH

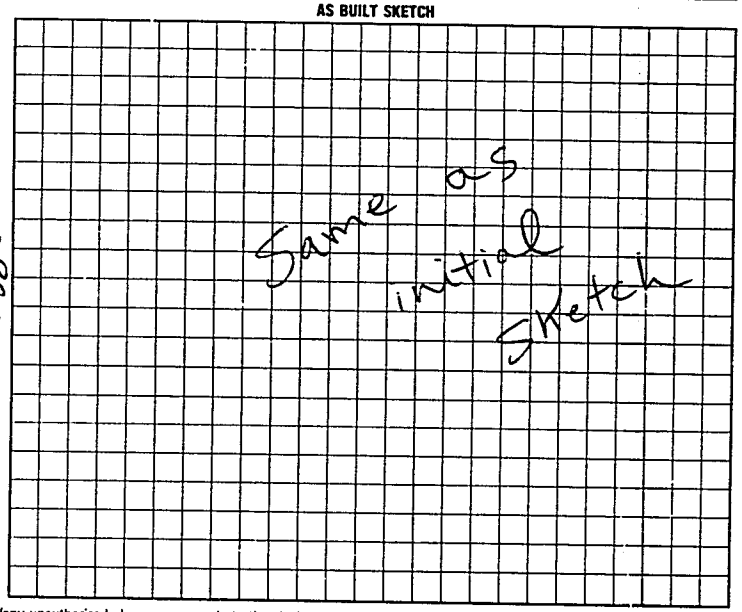

I understand that this permit can be suspended or revoked if any false information is supplied toward securing the permit/any unauthorized changes are made to the site/any unauthorized changes are made in the installation of the system.

Signed: Tommy Cothren

Improvement Permit by: L. C. Moore date 9-17-96

Authorization to Construct Existing System Inspection by: L. C. Moore date 9-17-96

Installed by: Tommy Cothren

Certificate of Completion by: date

Operation Permit by: L. C. Moore date 9-25-96

HEALTH DEPT. COPY: WHITE INSPECTION COPY (FINAL): GREEN OWNER COPY (FINAL): YELLOW INSPECTION COPY (INITIAL): PINK OWNER COPY (INITIAL): GOLD

Authorization to Construct Expires 60 mos from issue

0 1 2 0 0