# IREDELL COUNTY HEALTH DEPARTMENT

STATESVILLE 704-878-5305 MOORESVILLE 704-664-5281

## IMPROVEMENT PERMIT / CERTIFICATE OF COMPLETION / OPERATION PERMIT / EXISTING SYSTEM INSPECTION

PROPERTY DESCRIPTION NO. 68179 DATE 7-22-97 TAX MAP NO. 4712050488 Watershed: ☑ Yes ☐ No

OWNER OR CONTRACTOR John Blanscett PHONE: Business Home 881-0209 AUSTIN PA

ADDRESS 929 Enfola Rd

LOCATION Buffalo Shoals TR Enfola Rd Cross RR 3rd Dr. Rt

SUBDIVISION BLOCK / SECTION LOT LOT AREA .5 acres SITE CLASS. PS DESIGN FLOW 360 L.T.A.R. .3

Septic Tank: 1000 Gallons; STB 3794 Date 6-14-97

Pump Tank: Gallons; PT Date

Pump Make: Model Serial No.

Nitrification Field: No Fields 1 Square Feet 1200 Linear Feet 400

No Lines 5 Trench Width 36" Max Trench Bottom Depth 24" Gravel Depth 12"

☑ New System ☐ Repair System Type: I, II, III, IV, V, VI

System Description: Conv. Gravity

Repair System Description: Pump to Panels

Maintenance Agreement Required: ☐ Yes ☑ No

☐ House/Mod. Home No. Bedrooms 3

☑ Mobile Home No. Bathrooms 1

☐ Business No. Employees

☐ Other

☐ Slab ☑ Crawl Space ☐ Basement w/plumbing ☐ Basement wo/plumbing


Water Supply: ☑ Individual ☐ Community ☐ Public Well Next Door

Comments:


R/W ← To Enfola Rd

Comments:

INITIAL SITE SKETCH

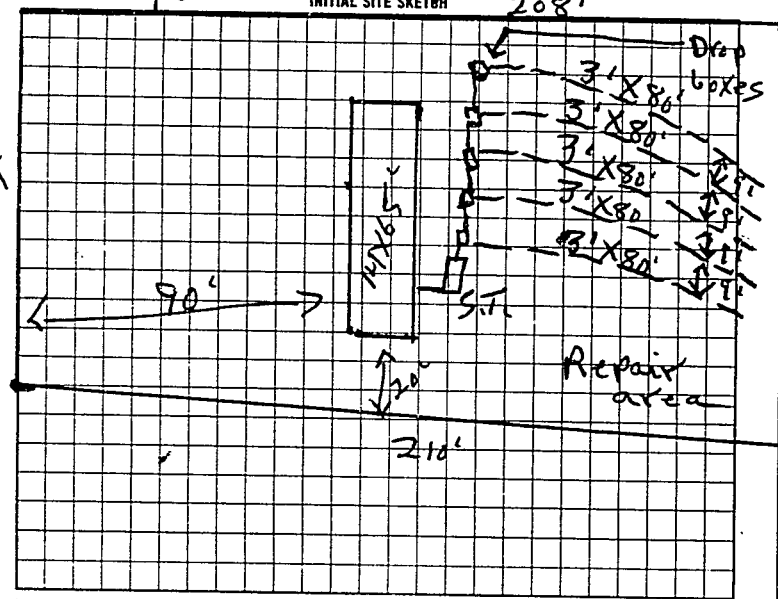


AS BUILT SKETCH

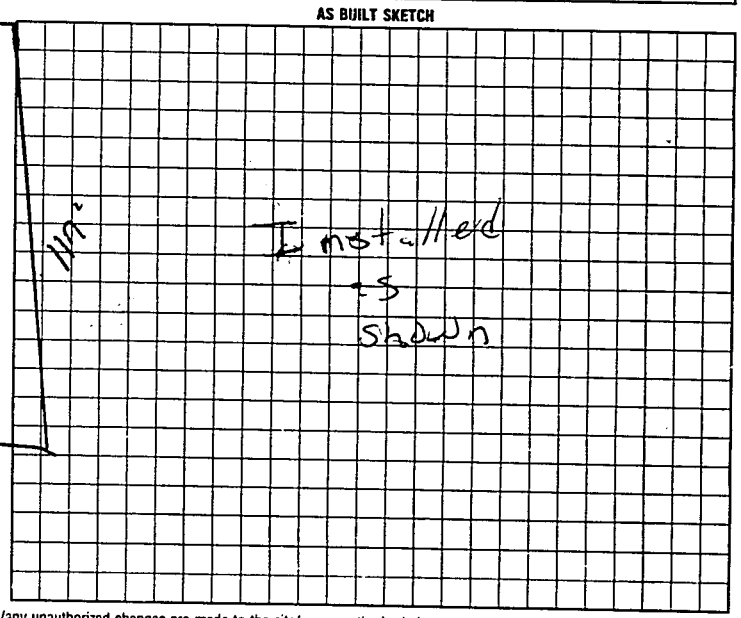


I understand that this permit can be suspended or revoked if any false information is supplied toward securing the permit/any unauthorized changes are made to the site/any unauthorized changes are made in the installation of the system. Improvement Permit is valid for 60 months from date of issuance.

Signed: John Blanscett

Improvement Permit by: L. C. Moore date 7-22-97

Existing System Inspection by: L. C. Moore date 7-22-97

Installed by: John Blanscett Jonas Hudder

Certificate of Completion by: date

Operation Permit by: 7 Months date 8-25-97

Authorization to cont.

HEALTH DEPT COPY (WHITE) INSPECTION COPY (FINAL) GREEN OWNER COPY (FINAL) YELLOW INSPECTION COPY (INITIAL) PINK OWNER COPY (INITIAL) GOLD

to cont. Authorization to cont. Expires 6 mos From issue

S E I E 0 0