IREDELL COUNTY HEALTH DEPARTMENT

STATESVILLE 704-878-5305 MOORESVILLE 704-664-5281 (cl)

IMPROVEMENT PERMIT / AUTHORIZATION TO CONSTRUCT / OPERATION PERMIT / EXISTING SYSTEM INSPECTION

PERMIT# 121133 PIN# 4702-95-7494 DATE 5-21-04

OWNER OR CONTRACTOR RICHARD HICKS PHONE: Business 704-929-9024 Home

ADDRESS 10501 CONISTAN PLACE, CORNELIUS NC 28031

LOCATION US 70 WEST, TL EUFOLA ROAD, TL HYDIE LANE, LOT STRAIGHT AHEAD 450'

SUBDIVISION BLOCK / SECTION LOT LOT AREA 0.5 ACRE SITE CLASS. PS DESIGN FLOW 360 L.T.A.R. 0.30 GPD

Septic Tank: 1000 Gallons; STB Date

Pump Tank: Gallons; PT Date

Pump Make: Model Serial No.

Nitrification Field: No Fields 1 Square Feet 1200 Linear Feet 400

No Lines FIVE Trench Width 36" Max Trench Bottom Depth 36" Gravel Depth 12"

☐ New System ☐ Repair System Type: I (II) III, IV, V, VI

System Description: CONVENTIONAL, GRAVITY

Repair System Description:

Maintenance Agreement Required: ☐ Yes ☒ No

☒ House/Mod. Home No. Bedrooms 3

☐ Mobile Home No. Bathrooms 2

☐ Business No. Employees

☐ Other


☐ Slab ☒ Crawl Space ☐ Basement w/plumbing ☐ Basement wo/plumbing

Water Supply: ☒ Individual ☐ Public ☐ Community NEIGHBORING WELL


Comments:/Conditions:

Comments:/Conditions: KEEP SYSTEM MINIMUM FIVE (5) FEET FROM HOME.

INITIAL SITE SKETCH

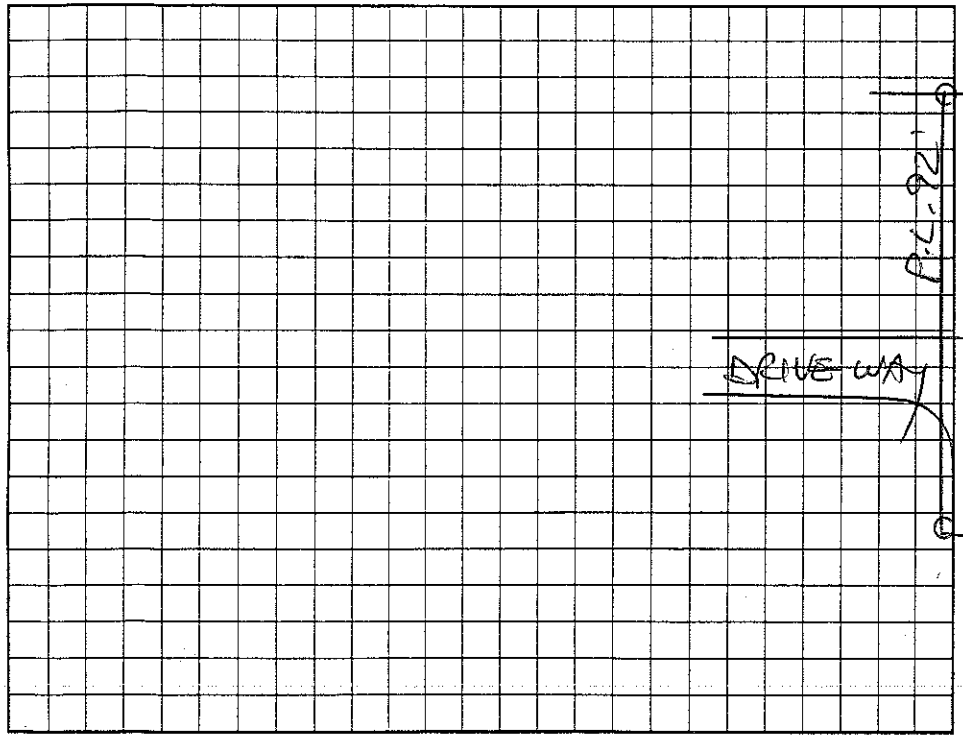

AS BUILT SKETCH ~ SCALE: 1" = 40'

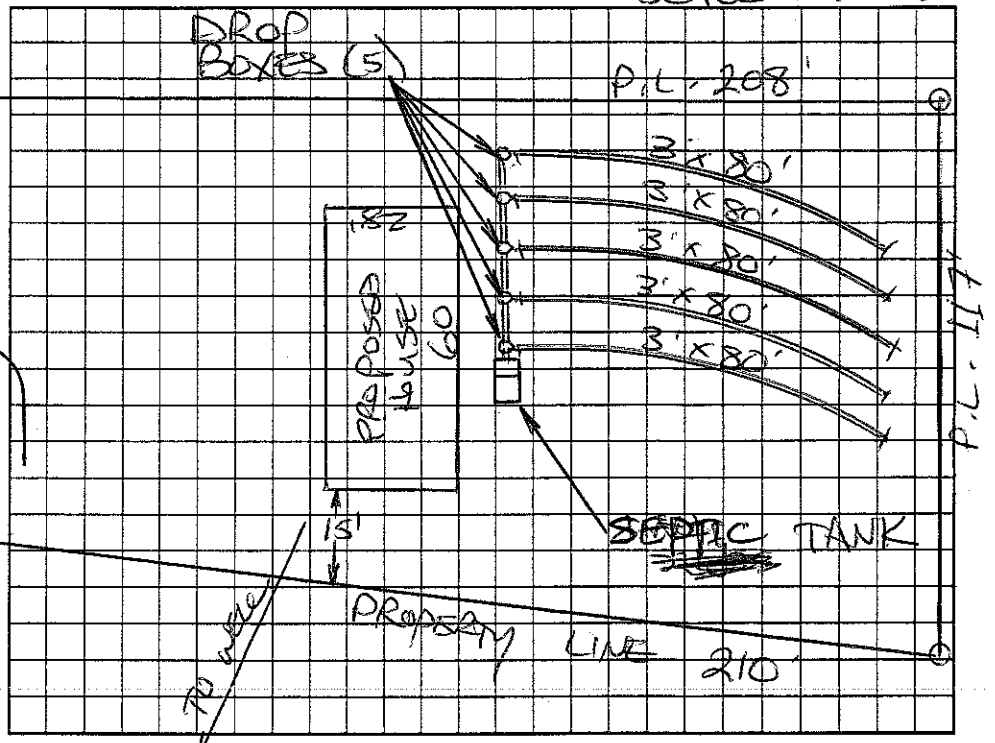

Permit can be suspended or revoked if any false information is supplied toward securing the permit/any unauthorized changes are made to the site/any unauthorized changes are made in the installation of the system. Improvement Permit with plat valid without expiration. Improvement Permit with site plan valid for sixty months. Authorization to Construct is valid for a period equal to that of Improvement Permit – not to exceed sixty months.

Signed: date Installed by:

Improvement Permit by: date Operation Permit by: date

Authorization to Construct by: date Existing System Inspection by: STEVE HENDRICK date 5-21-04

HEALTH DEPT. COPY: WHITE OWNER COPY (FINAL): YELLOW OWNER COPY (INITIAL): PINK