IREDELL COUNTY HEALTH DEPARTMENT

Statesville Office (704) 878-5305 Mooresville Office (704) 660-3625

IMPROVEMENT PERMIT / AUTHORIZATION TO CONSTRUCT / OPERATION PERMIT / EXISTING SYSTEM

PERMIT # 216596

PIN # 4702958371 8214

APPLICANT: Ted Hicks APPLICANT ADDRESS: 927 Eufola Rd Statesville NC

SITE ADDRESS: 929 Eufola Rd Statesville NC PHONE: 704-929-9024 ALT. PHONE: N/A

SITE DIRECTIONS: Buffalo Shoals toward Catawba T/R Eufola Rd lot 6n right

SUBDIVISION: N/A SECTION: N/A LOT # N/A LOT AREA: 4ac DESIGN FLOW: Ex L.T.A.R.: Ex

Septic Tank	Ex (gal)	STB	Date				
Pump Tank	(gal)	PT	Date				
Pump Make		Model	Serial #				
# Nitrification Fields	Ex	# Lines	Ex	Linear Ft:	Ex		
Trench Width	Ex	Max. Trench Bottom Depth	Ex	Gravel Depth	Ex		

☐ New System ☐ Repair ☐ Expansion System Type: I ☒ II III IV V VI

System Description: Existing

Repair System Description:

Maintenance Agreement Required: ☐ YES ☒ NO

☒ GRAVITY ☐ PRESSURE

☒ Residence ☐ Business ☐ Other ☐ Slab ☐ Basement w/plumbing


No. Bedrooms Ex No. Persons Ex No. Employees ☒ Crawl Space

Water Supply: ☒ Private ☐ Public ☐ Community


☐ Basement w/o plumbing

Comments / Conditions: All building foundations must be 75' from any part of STS

INITIAL SITE SKETCH

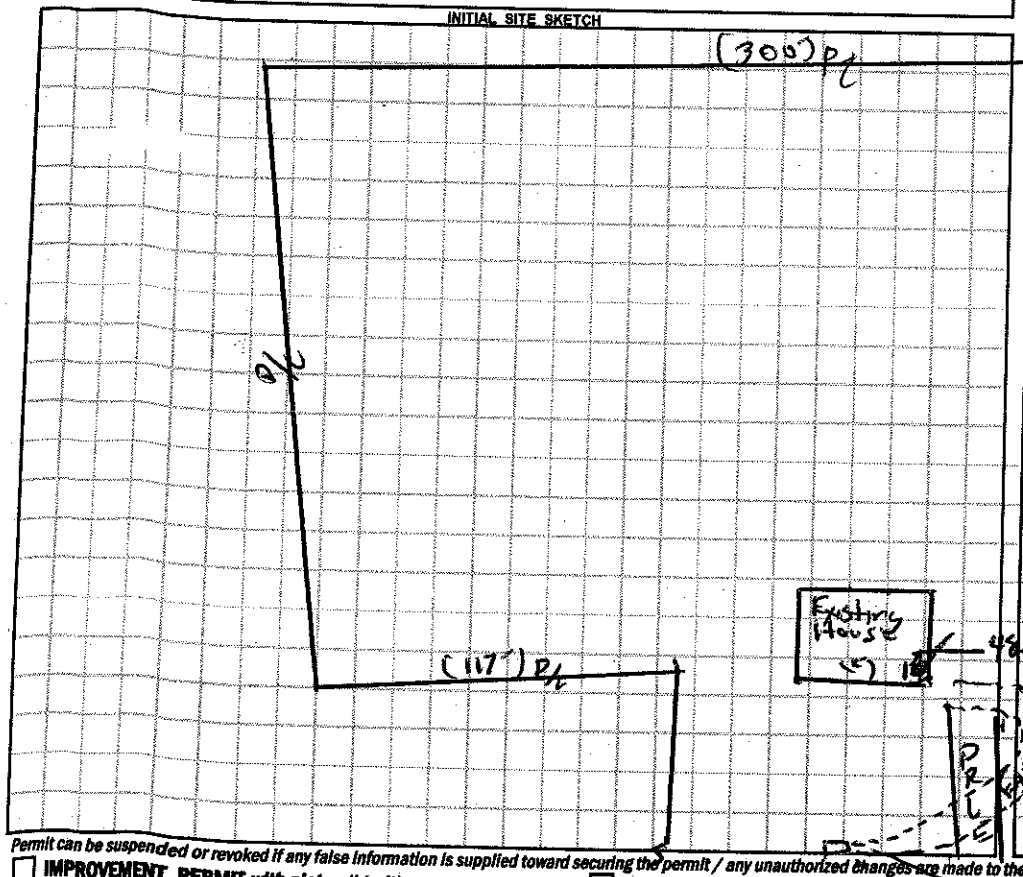

AS BUILT SKETCH

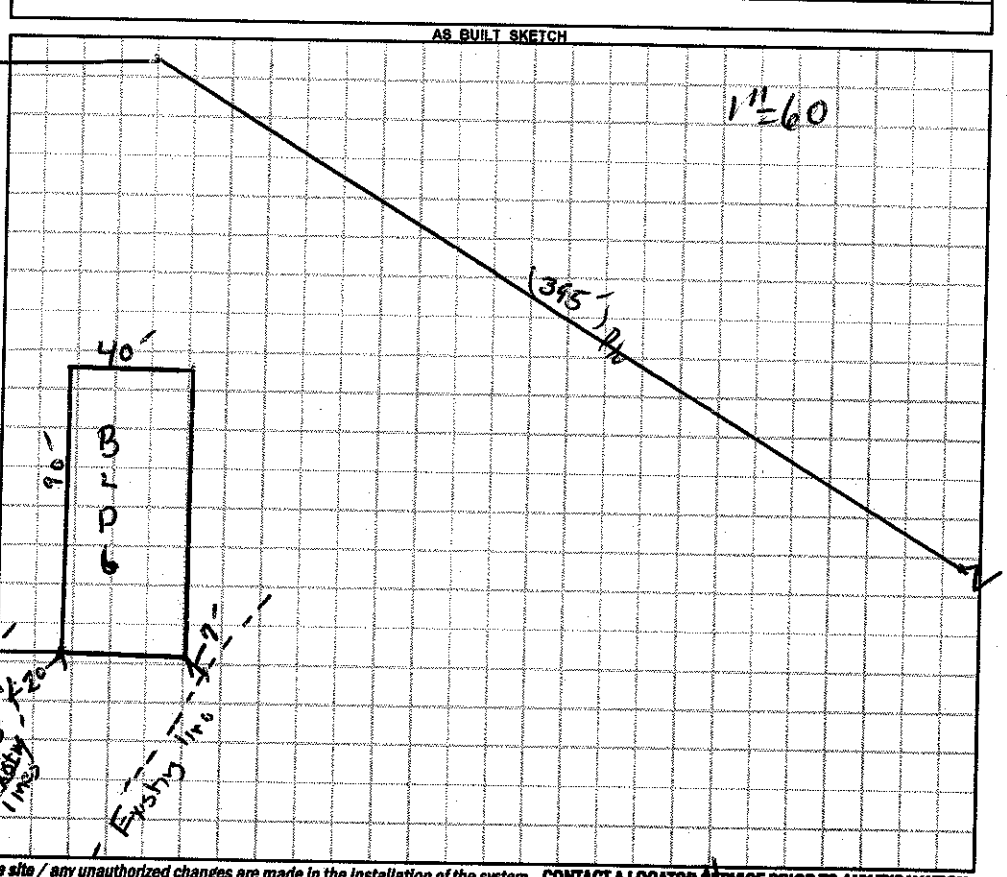

Permit can be suspended or revoked if any false information is supplied toward securing the permit / any unauthorized changes are made to the site / any unauthorized changes are made in the installation of the system. CONTACT A LOCATOR SERVICE PRIOR TO ANY EXCAVATION

☐ **IMPROVEMENT PERMIT** *with plat valid without expiration.* ☐ **IMPROVEMENT PERMIT** *with site plan valid for 60 mos.* ☐ **AUTHORIZATION TO CONSTRUCT** *valid for period equal to IMPROVEMENT PERMIT--not to exceed 60 mo.*

Owner / Applicant Signature: issued w/o signature 2/29/16 Date: Installed by:

IMPROVEMENT PERMIT by: Date: OPERATION PERMIT by: Date:

AUTHORIZATION TO CONSTRUCT by: Date: Existing System Inspected by: Date: 02/25/16

Health Dept. Copy - WHITE Applicant (Final Approval) - YELLOW Applicant (Conditional Approval) - PINK