IREDELL COUNTY HEALTH DEPARTMENT

STATESVILLE 704-878-5305 MOORESVILLE 704-664-5281

IMPROVEMENT PERMIT / AUTHORIZATION TO CONSTRUCT / OPERATION PERMIT / EXISTING SYSTEM INSPECTION

PERMIT# X PIN# X DATE 4-28-99

OWNER OR CONTRACTOR WALTER SNOOKS PHONE: Business 872 2785 Home

ADDRESS 194 Pinedell Acres Dr

LOCATION E Lewis Ferry Rd (L) Pinedell Acres End of Road on Left

SUBDIVISION BLOCK / SECTION LOT LOT AREA SITE CLASS. DESIGN FLOW L.T.A.R.

Septic Tank: 1000 Gallons; STB Date

Pump Tank: Gallons; PT Date

Pump Make: Model Serial No.

Nitrification Field: No Fields ~~Existing~~ Square Feet Linear Feet

No Lines Trench Width Max Trench Bottom Depth Gravel Depth

☐ New System ☒ Repair System Type: I. II. III. IV. V. VI

System Description: Existing

Repair System Description:

Maintenance Agreement Required: ☐ Yes ☒ No

☐ House/Mod. Home No. Bedrooms 3

☒ Mobile Home No. Bathrooms 2

☐ Business No. Employees

☐ Other

☐ Slab ☒ Crawl Space ☐ Basement w/plumbing ☐ Basement wo/plumbing


Water Supply: ☒ Individual ☐ Public ☐ Community WELL

Comments/Conditions: Pump & Crush & fill old TANK
Locate outlet Line And Relocate if closer than 10ft
To Gravel Drive CALL 928-2030 if any questions

Comments/Conditions

* Note: Repair permit for new drainlines issued 5-14-99

INITIAL SITE SKETCH

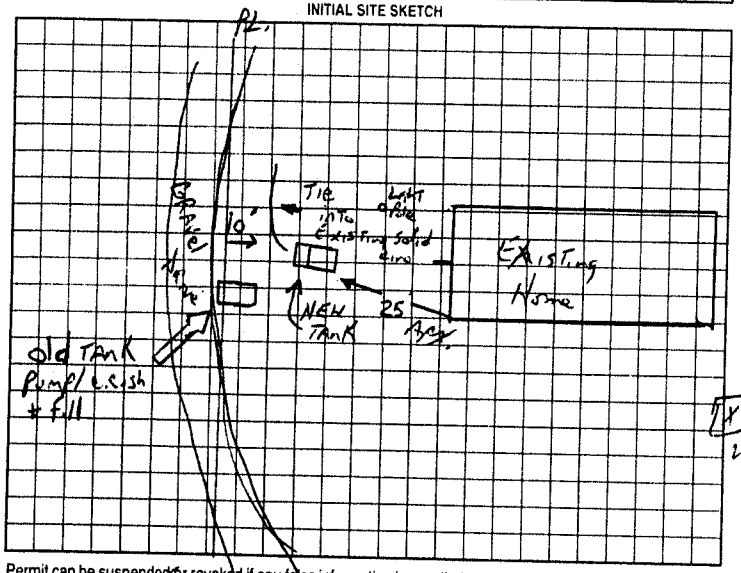

AS BUILT SKETCH

Permit can be suspended or revoked if any false information is supplied toward securing the permit/any unauthorized changes are made to the site/any unauthorized changes are made in the installation of the system. Improvement Permit with plat valid without expiration. Improvement Permit with site plan valid for sixty months. Authorization to Construct is valid for a period equal to that of Improvement Permit – not to exceed sixty months.

Signed: Walter W. Snooks date 4-28-99 Installed by: James Hudler

Improvement Permit by: Jeff Potts date 4-28-99 Operation Permit by: Mark Cox date 5-14-99

Authorization to Construct by: Jeff Potts date 4-28-99 Existing System Inspection by: date

HEALTH DEPT COPY WHITE OWNER COPY (FINAL) YELLOW OWNER COPY (INITIAL) PINK