IREDELL COUNTY HEALTH DEPARTMENT

STATESVILLE 704-878-5305 MOORESVILLE 704-664-5281

IMPROVEMENT PERMIT / AUTHORIZATION TO CONSTRUCT / OPERATION PERMIT / EXISTING SYSTEM INSPECTION

PERMIT# _____ PIN# _____ DATE 2-19-99

OWNER OR CONTRACTOR Gary Harris PHONE: Business _____ Home 872-1469

ADDRESS 202 Pinedell acres

LOCATION own n turn East Lewis Ferry Th Pinedell at end Rt

SUBDIVISION _____ BLOCK / SECTION _____ LOT _____ LOT AREA 2.12 ac SITE CLASS PS DESIGN FLOW 360 L.T.A.R. .43

Septic Tank: EX Gallons; STB 794 Date 12-27-98
Pump Tank: _____ Gallons; PT _____ Date _____
Pump Make: _____ Model _____ Serial No. _____
Nitrification Field: No Fields 1 Square Feet 900 Linear Feet 300
No Lines 3 Trench Width 36" Max Trench Bottom Depth 36" Gravel Depth 12"

☑ New System ☐ Repair System Type: I. II. III. IV. V. VI
System Description: Conv.
Repair System Description: Conv. Gravity
Maintenance Agreement Required: ☐ Yes ☑ No


☑ House/Mod Home No. Bedrooms 3
☐ Mobile Home No. Bathrooms 2
☐ Business No. Employees _____
☐ Other _____
☐ Slab ☑ Crawl Space ☐ Basement w/plumbing ☐ Basement wo/plumbing

Water Supply: ☐ Individual ☑ Public ☐ Community


Comments/Conditions:

Comments/Conditions: Replaced old tank with new

INITIAL SITE SKETCH

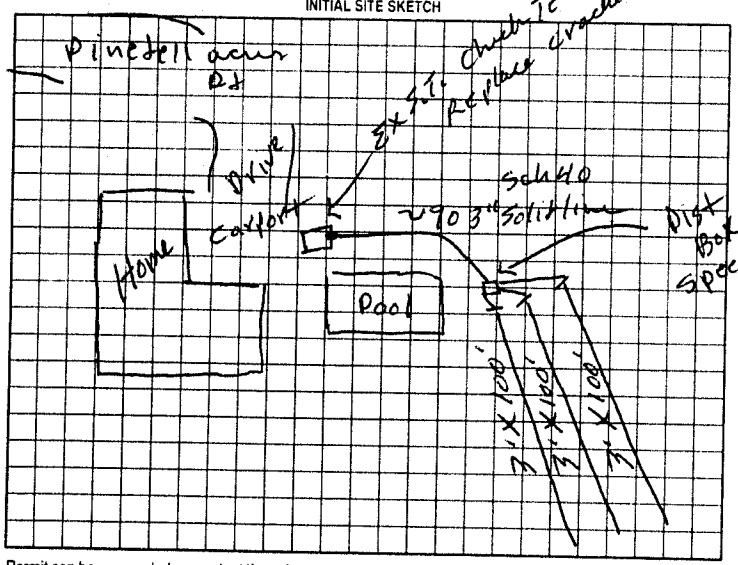

AS BUILT SKETCH

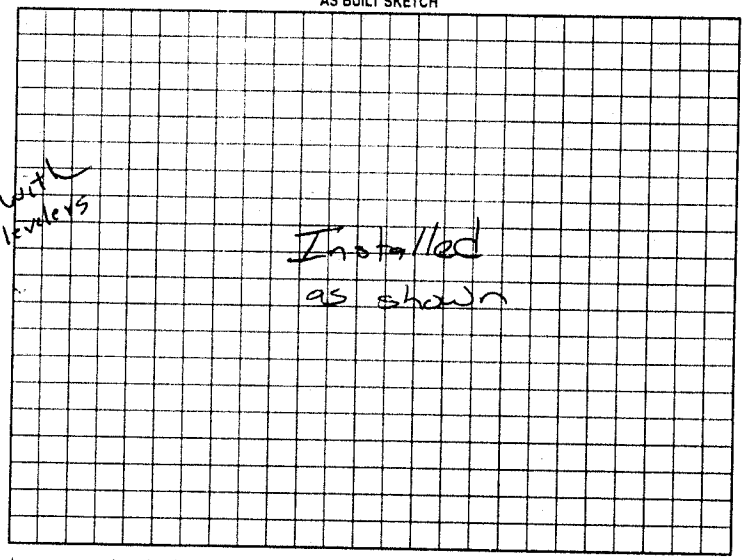

Permit can be suspended or revoked if any false information is supplied toward securing the permit/any unauthorized changes are made to the site/any unauthorized changes are made in the installation of the system. Improvement Permit with plat valid without expiration. Improvement Permit with site plan valid for sixty months. Authorization to Construct is valid for a period equal to that of Improvement Permit – not to exceed sixty months.

Signed: _____ date _____ Installed by: James Hudler

Improvement Permit by: D.C. Moore date 2-19-99 Operation Permit by: Mark C Ortz RS date 3-2-99

Authorization to Construct by: D.C. Moore date 2-19-99 Existing System Inspection by: _____ date _____

HEALTH DEPT COPY WHITE OWNER COPY (FINAL) YELLOW OWNER COPY (INITIAL) PINK