EXISTING

IREDELL COUNTY HEALTH DEPARTMENT

STATESVILLE 704-878-5305 MOORESVILLE 704-664-5281

IMPROVEMENT PERMIT / AUTHORIZATION TO CONSTRUCT / OPERATION PERMIT / EXISTING SYSTEM INSPECTION

PERMIT# 142920 PIN# 4702999708 DATE 6-7-07

OWNER OR APPLICANT Gary E Harris PHONE: Business _____ Home 704-872-1469

ADDRESS 202 Pinedell Acres Drive Statesville NC 28677

LOCATION OnR (R) LEWIS FERRY (L) Pinedale Acres AT END

SUBDIVISION _____ BLOCK / SECTION _____ LOT _____ LOT AREA 2.07 AC SITE CLASS PS DESIGN FLOW 360 L.T.A.R. .5

Septic Tank: 1000 Gallons; STB _____ Date _____

Pump Tank: _____ Gallons; PT _____ Date _____

Pump Make: _____ Model _____ Serial No. _____

Nitrification Field: No Fields 1 Square Feet 720' Linear Feet 240'

No Lines 3 Trench Width EXISTING Max Trench Bottom Depth EXISTING Gravel Depth 12" ☒ Gravity ☐ Pressure

☒ New System ☐ Repair ☐ Expansion System Type: I (II) III IV V VI

System Description: EXISTING GRAVITY CONV

Repair System Description: _____

Maintenance Agreement Required: ☐ Yes ☒ No

☐ House/Mod. Home ☒ Mobile Home ☐ Business ☐ Other

No. Bedrooms 3 No. Persons 6 No. Employees _____

Water Supply: ☐ Individual ☒ Public ☐ Community

☐ Slab ☒ Crawl Space ☐ Basement w/plumbing ☐ Basement wo/plumbing

Comments:/Conditions:
(1) This is AN EXISTING SYSTEM
CHECK (2) This is a properly functioning System in use at time of check (3) Maintain Setbacks

Comments:/Conditions:

INITIAL SITE SKETCH

SEE ATTACHED SYSTEM DESIGN BY LORNE COOK, R.S.
THIS IS AN EXISTING SYSTEM CHECK

AS BUILT SKETCH

Permit can be suspended or revoked if any false information is supplied toward securing the permit/any unauthorized changes are made to the site/any unauthorized changes are made in the installation of the system. Improvement Permit with plat valid without expiration ☐ Improvement Permit with site plan valid for sixty months ☐ Authorization to Construct is valid for a period equal to that of Improvement Permit – not to exceed sixty months.

Signed: Gary Harris date 6-8-07

Improvement Permit by: _____ date _____

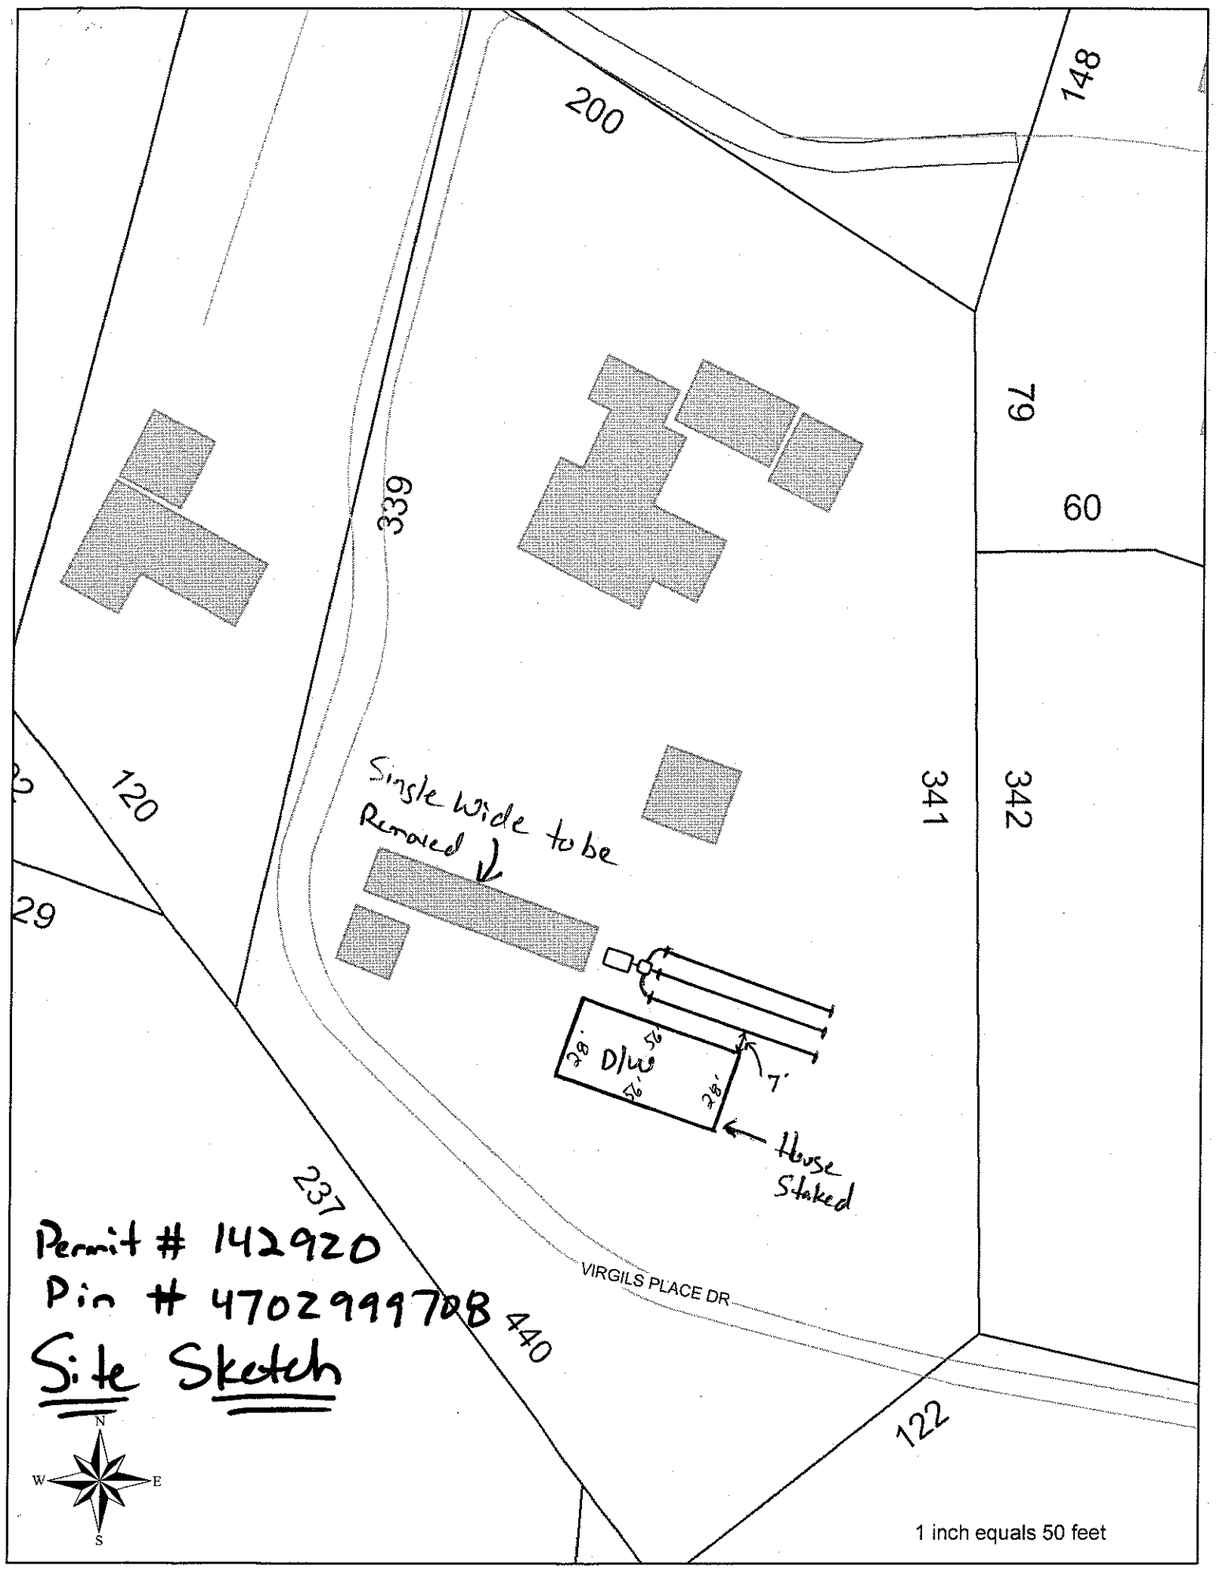
Authorization to Construct by: _____ date _____

Installed by: HARRY REEP

Operation Permit by: _____ date _____

Existing System Inspection by: [signature] PS date 6-7-07

HEALTH DEPT. COPY: WHITE OWNER COPY (FINAL): YELLOW OWNER COPY (INITIAL): PINK


200
148
339
79
60
120
Single Wide to be Removed
341
342
29
28'
D/W
52'
26'
28'
7'
House Staked
237
Permit # 142920
Pin # 4702999708
440
VIRGILS PLACE DR
122
Site Sketch
N
W
E
S
1 inch equals 50 feet