IREDELL COUNTY HEALTH DEPARTMENT

STATESVILLE 704-878-5305 MOORESVILLE 704-664-5281

IMPROVEMENT PERMIT / CERTIFICATE OF COMPLETION / OPERATION PERMIT / EXISTING SYSTEM INSPECTION

PROPERTY DESCRIPTION NO. 11050 DATE 9-12-95 TAX MAP NO. 8H-4-6-33 Watershed: ☐ Yes ☑ No

OWNER OR CONTRACTOR Michael Heaton (74 properties) PHONE: Business 532-6527 Home

ADDRESS 5551 Monroe Rd. Charolette, N.C. 28212

LOCATION I-40W TL Old Mtn. Rd. TR Hwy 70 TL Wind Forest bare R at fork Lot on L just before cul-de-sac.

SUBDIVISION Wind Forest BLOCK / SECTION III LOT 33 LOT AREA .9857 acres SITE CLASS. P.S. DESIGN FLOW 240 L.T.A.R. .3 gpd/ft²

Septic Tank: 1000 Gallons; STB 1012 Date 9-14-98
Pump Tank: — Gallons; PT — Date —
Pump Make: — Model — Serial No. —
Nitrification Field: No Fields 1 Square Feet 810 Linear Feet 270'
No Lines 3 Trench Width 36" Max Trench Bottom Depth 36" Gravel Depth 12"

☑ New System ☐ Repair System Type: I, (II), III, IV, V, VI
System Description: Conventional, gravity fed
Repair System Description: "
Maintenance Agreement Required: ☐ Yes ☑ No

☐ House/Mod. Home ☑ Mobile Home ☐ Business ☐ Other
No. Bedrooms 2 No. Bathrooms 2 No. Employees —


☐ Slab ☑ Crawl Space ☐ Basement w/plumbing ☐ Basement wo/plumbing

Water Supply: ☑ Individual ☐ Community ☐ Public

Comments: Install system no deeper than 24" to trench bottom on lower side of trench and no deeper than 36" to trench bottom on upper side of trench. Keep lines and trenches on contour. Keep system 5' from foundation of home, 10' from all property lines, and max. feasable distance from any well and no closer than 50'. 100% Repair below system Chambered Graveless System. gravity fed.

(LOT STEEP - 30% Slope)

INITIAL SITE SKETCH

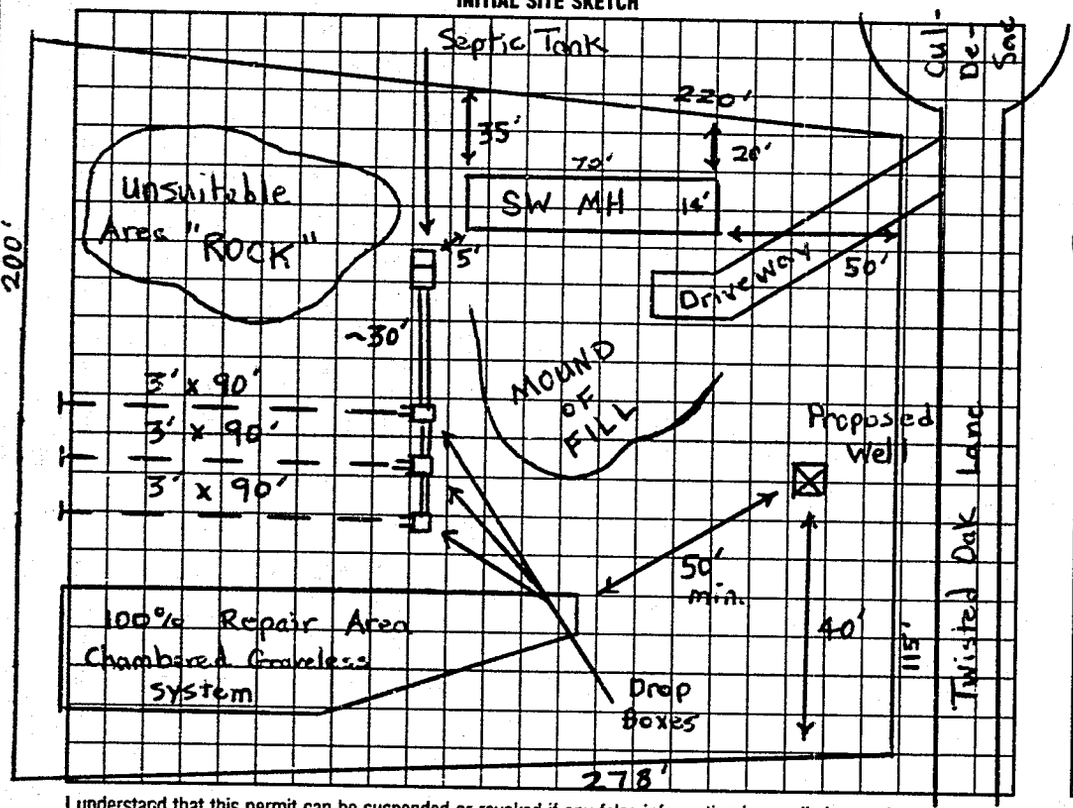

AS BUILT SKETCH

Same as initial sketch

I understand that this permit can be suspended or revoked if any false information is supplied toward securing the permit/any unauthorized changes are made to the site/any unauthorized changes are made in the installation of the system.

Signed: Edna M. Heaton

Improvement Permit by: Michael J. Dennis date 9-12-95

Existing System Inspection by: — date —

Installed by: Steve Jordan

Certificate of Completion by: — date —

Operation Permit by: L. C. Moore date 11-24-98

HEALTH DEPT. COPY: WHITE INSPECTION COPY (FINAL): GREEN OWNER COPY (FINAL): YELLOW INSPECTION COPY (INITIAL): PINK OWNER COPY (INITIAL): GOLD