IREDELL COUNTY HEALTH DEPARTMENT

STATESVILLE 704-878-5305 MOORESVILLE 704-664-5281 (C1)

IMPROVEMENT PERMIT / AUTHORIZATION TO CONSTRUCT / OPERATION PERMIT / EXISTING SYSTEM INSPECTION

PERMIT# 1160288 PIN# 4703-01-6591 DATE 10-17-03

OWNER OR CONTRACTOR DONNA ALBERRY PHONE: Business Home 704-871-9593

ADDRESS 168 BOLICK ROAD, SIDNY POINT, NC 28678

LOCATION US 70 WEST, TL WINDFOREST DRIVE, LOT ON LEFT ACROSS FROM WOODBROOK LANE

SUBDIVISION WIND FOREST BLOCK / SECTION B LOT 21 LOT AREA 1.30 ACRES SITE CLASS. PS DESIGN FLOW 240 (480) T.A.R. 0.30 GPD/FT²

Septic Tank: 1000 Gallons; STB ____ Date ____

Pump Tank: ____ Gallons; PT ____ Date ____

Pump Make: ____ Model ____ Serial No. ____

Nitrification Field: No Fields 1 Square Feet EQ TO 1800 Linear Feet 300

No Lines FIVE Trench Width 24" Max Trench Bottom Depth 36"

☐ New System ☐ Repair System Type: I, II, (III), IV, V, VI

System Description: 50% REDUCTION GRAVITY

Repair System Description: LOW PRESSURE PIPE

Maintenance Agreement Required: ☐ Yes ☑ No

☐ House/Mod. Home No. Bedrooms (2)

☑ Mobile Home No. Bathrooms 1

☐ Business No. Employees ____

☐ Other ____


Water Supply: ☐ Individual ☐ Public ☑ Community

~~Gravel~~ Depth SAND 24" ☐ Slab ☑ Crawl Space ☐ Basement w/plumbing ☐ Basement wo/plumbing


Comments:/Conditions:

Comments:/Conditions:

INITIAL SITE SKETCH

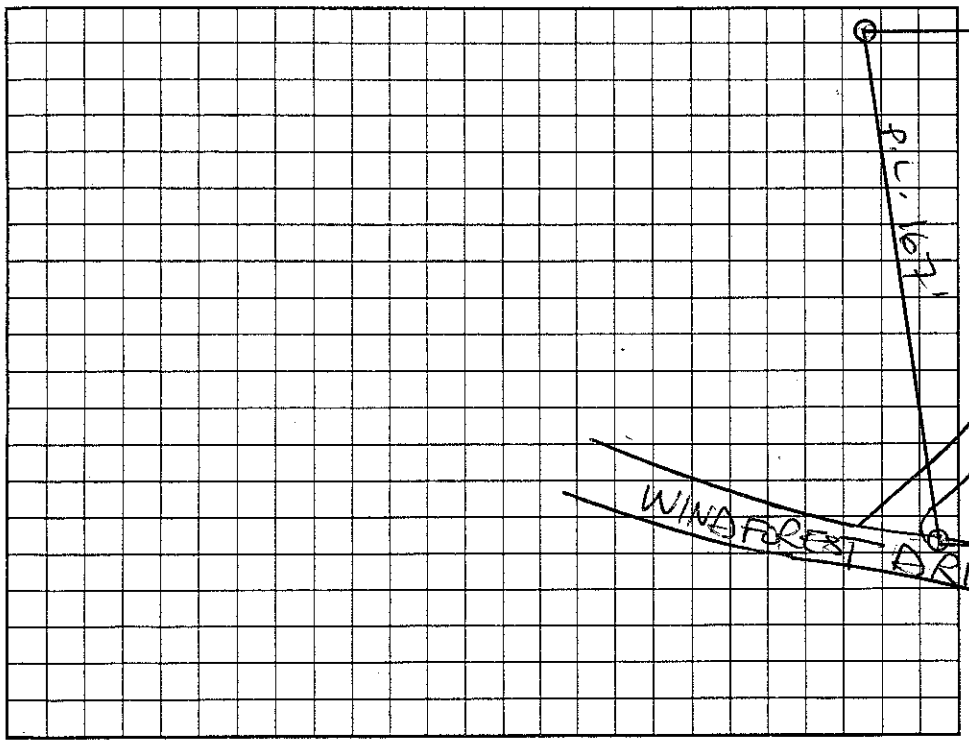

AS BUILT SKETCH

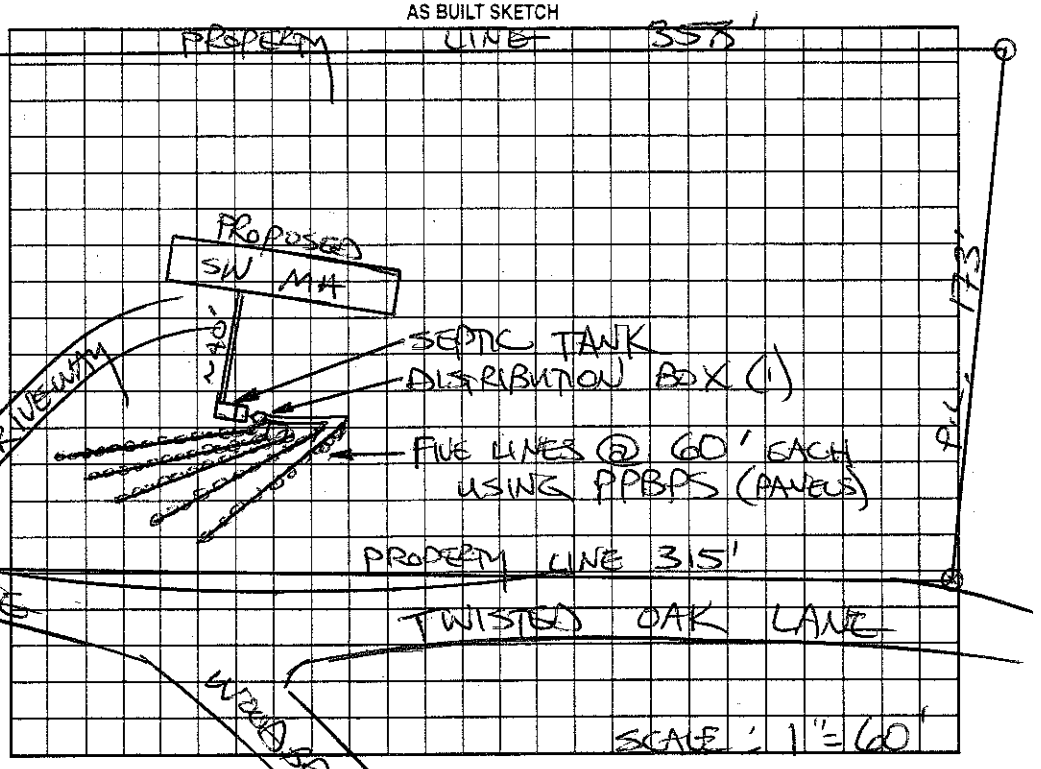

Permit can be suspended or revoked if any false information is supplied toward securing the permit/any unauthorized changes are made to the site/any unauthorized changes are made in the installation of the system. Improvement Permit with plat valid without expiration. Improvement Permit with site plan valid for sixty months. Authorization to Construct is valid for a period equal to that of Improvement Permit – not to exceed sixty months.

Signed: ____ date ____

Improvement Permit by: ____ date ____

Authorization to Construct by: ____ date ____

Installed by: ____

Operation Permit by: ____ date ____

Existing System Inspection by: STEVE HARRICK date 10-17-03

HEALTH DEPT. COPY: WHITE OWNER COPY (FINAL): YELLOW OWNER COPY (INITIAL): PINK