06345|

IREDELL COUNTY HEALTH DEPARTMENT

STATESVILLE 704-878-5305 MOORESVILLE 704-664-5281

IMPROVEMENT PERMIT / CERTIFICATE OF COMPLETION / OPERATION PERMIT / EXISTING SYSTEM INSPECTION

PROPERTY DESCRIPTION NO. 23604 DATE 5-15-96 TAX MAP NO. 8H-4-B-4 Watershed: ☐ Yes ☐ No

OWNER OR CONTRACTOR Robert E Fox II PHONE: Business Home 872-4372

ADDRESS 272 old miller Rd Statesville

LOCATION 70 W TL windsor Rd 3rd lot Rt.

SUBDIVISION Winfrost BLOCK / SECTION LOT 4 LOT AREA approx acre SITE CLASS. DESIGN FLOW 360 L.T.A.R. .3

Septic Tank: 1000 Gallons; STB 620 Date 9-24-95
Pump Tank: Gallons; PT Date
Pump Make: Model Serial No.
Nitrification Field: No Fields 1 Square Feet 1200 Linear Feet 400
No Lines 5 Trench Width 36" Max Trench Bottom Depth 24" Gravel Depth 12"

☑ New System ☐ Repair System Type: I (II) III, IV, V, VI
System Description: Conv. Gravity Pump
Repair System Description:
Maintenance Agreement Required: ☐ Yes ☑ No


☐ House/Mod. Home No. Bedrooms 3
☑ Mobile Home No. Bathrooms 2
☐ Business No. Employees
☐ Other
☐ Slab ☑ Crawl Space ☐ Basement w/plumbing ☐ Basement wo/plumbing

Water Supply: ☐ Individual ☐ Community ☑ Public


Comments:
Run Drain lines on contour of hill

Comments:

INITIAL SITE SKETCH

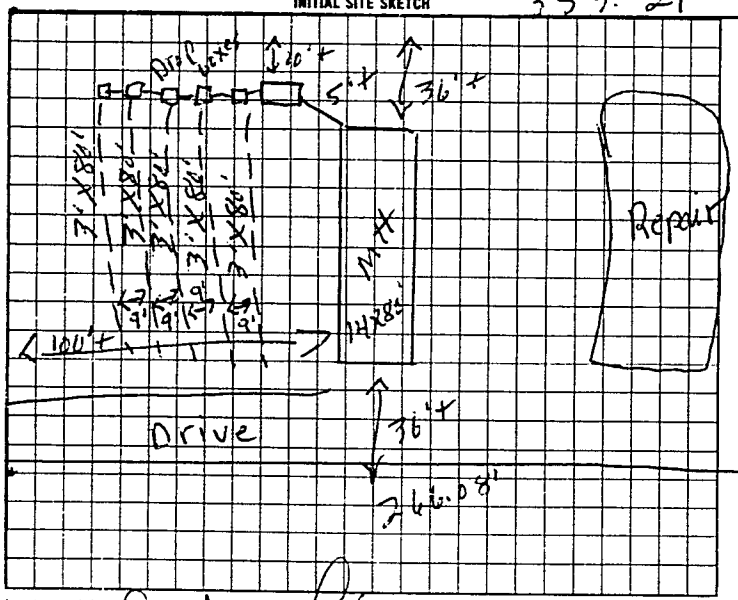

AS BUILT SKETCH

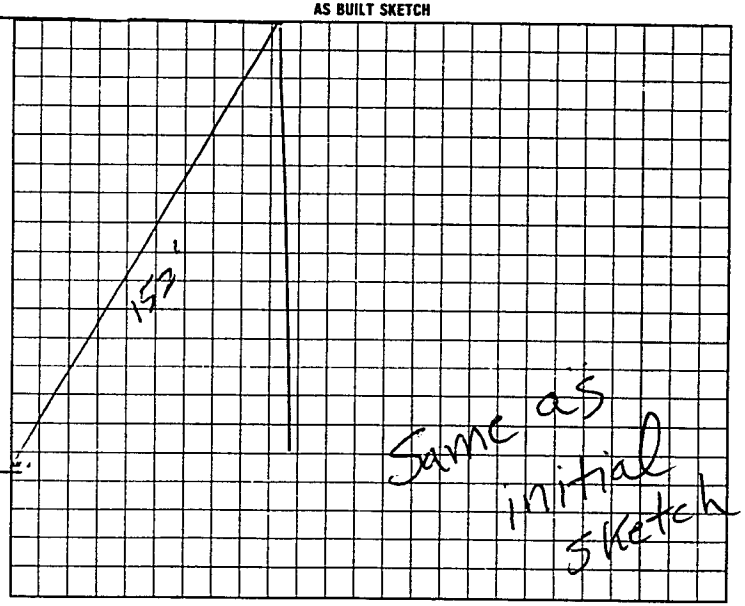

I understand that this permit can be suspended or revoked if any false information is supplied toward securing the permit/any unauthorized changes are made to the site/any unauthorized changes are made in the installation of the system.

Signed X Robert E Fox

Improvement Permit by R. C. Moore date 5-15-96

Existing System Inspection by R. C. Moore date 5-15-96

Authorization to Const.

Installed by Sammy Reavis

Certificate of Completion by date

Operation Permit by R. C. Moore date 9-25-96

HEALTH DEPT COPY WHITE INSPECTION COPY (FINAL) GREEN OWNER COPY (FINAL) YELLOW INSPECTION COPY (INITIAL) PINK OWNER COPY (INITIAL) GOLD

Authorization to Const. Expires 6 mos from issue

2 2 1 0 0 0