pds/25 11-5-97

IREDELL COUNTY HEALTH DEPARTMENT

STATESVILLE 704-878-5305 MOORESVILLE 704-664-5281

IMPROVEMENT PERMIT / CERTIFICATE OF COMPLETION / OPERATION PERMIT / EXISTING SYSTEM INSPECTION

PROPERTY DESCRIPTION NO. 69641 DATE 10-20-97 TAX MAP NO. 3792-26-8055 Watershed: ☑ Yes ☐ No

OWNER OR CONTRACTOR PeeKS Inc. PHONE: Business 704 567 9836 Home ~~LOT IV~~ CA

ADDRESS 5201 Monroe Road Charlotte N.C.

LOCATION US 74 west on left before windforest

SUBDIVISION Meadow creek BLOCK / SECTION ____ LOT 4 LOT AREA .78 acres SITE CLASS. PS DESIGN FLOW 360 L.T.A.R. .3

Septic Tank: 1000 Gallons; STB 1012 Date 2-25-98
Pump Tank: ____ Gallons; PT ____ Date ____
Pump Make: ____ Model ____ Serial No. ____
Nitrification Field: No Fields 1 Square Feet 900 Linear Feet 300
No Lines 4 Trench Width 36" Max Trench Bottom Depth 36" Gravel Depth N/A

☑ New System ☐ Repair System Type: I, II, III, IV, V, VI
System Description: Chamber Gravity/ or HPS
Repair System Description: " "
Maintenance Agreement Required: ☐ Yes ☐ No


☐ House/Mod. Home No. Bedrooms 3
☑ Mobile Home No. Bathrooms 2
☐ Business No. Employees ____
☐ Other ____
☐ Slab ☐ Crawl Space ☐ Basement w/plumbing ☐ Basement wo/plumbing

Water Supply: ☐ Individual ☐ Community ☑ Public


Comments:

Comments:

INITIAL SITE SKETCH

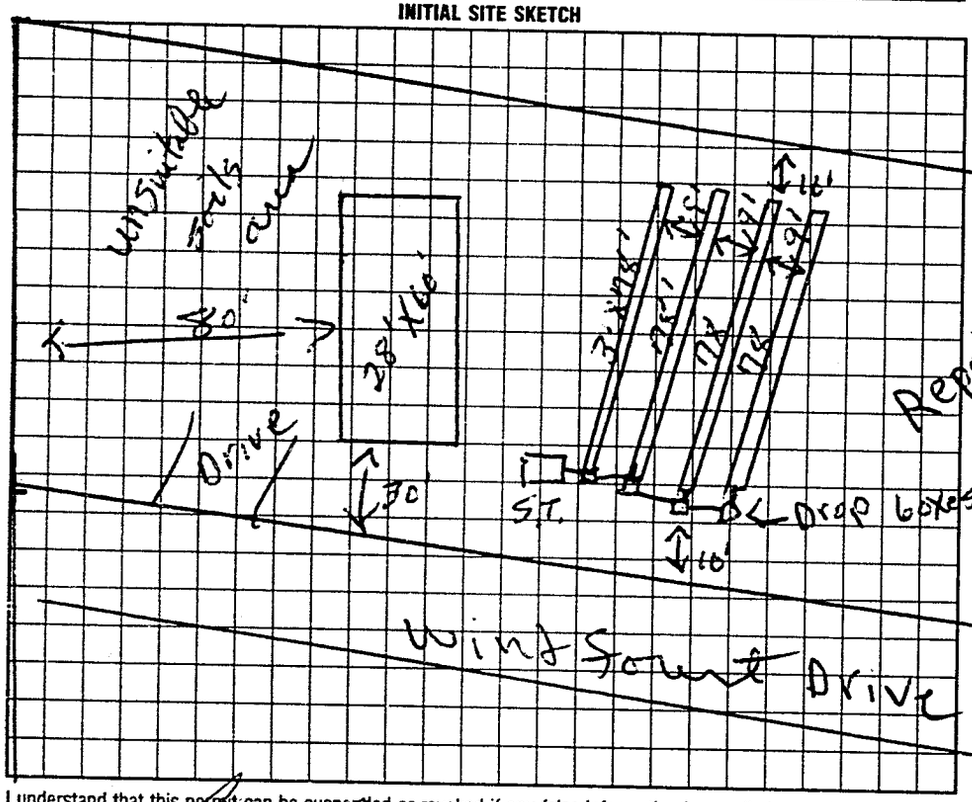

AS BUILT SKETCH

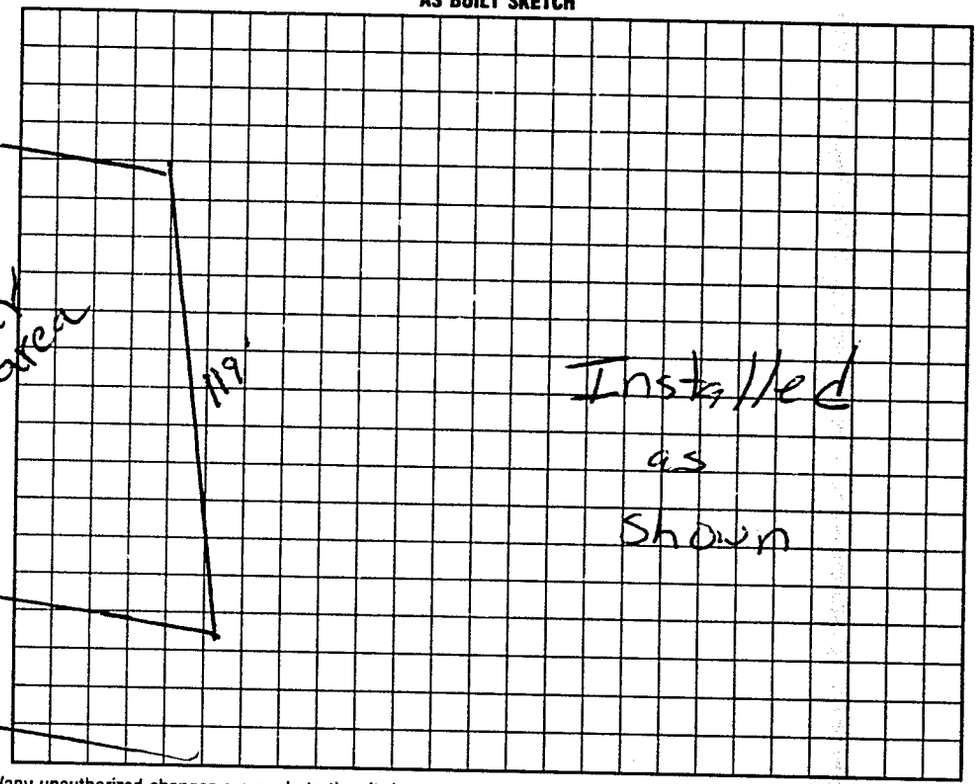

I understand that this permit can be suspended or revoked if any false information is supplied toward securing the permit/any unauthorized changes are made to the site/any unauthorized changes are made in the installation of the system. Improvement Permit is valid for 60 months from date of issuance.

Signed: Mike Moore, President

Improvement Permit by: D. C. Moore date 10-20-97

Existing System Inspection by: D. C. Moore date 10-20-97

Authorization to cover.

Installed by: A-1 Backhoe

Certificate of Completion by: ____ date ____

Operation Permit by: Mat COATES date 4-29-98

HEALTH DEPT. COPY: WHITE INSPECTION COPY (FINAL): GREEN OWNER COPY (FINAL): YELLOW INSPECTION COPY (INITIAL): PINK OWNER COPY (INITIAL): GOLD

Authorization to cover. Expires 60 mos from issue