11:15

IREDELL COUNTY HEALTH DEPARTMENT

STATESVILLE 704-878-5305 MOORESVILLE 704-664-5281

IMPROVEMENT PERMIT / AUTHORIZATION TO CONSTRUCT / OPERATION PERMIT / EXISTING SYSTEM INSPECTION

PERMIT# 73271 PIN# 3792 26 8055 DATE 5-11-98

OWNER OR CONTRACTOR Tammy Scott PHONE: Business Home 871 8332

ADDRESS 745-B Front St. Statesville, N.C.

LOCATION 70 West on left before Wint Forest Drive

SUBDIVISION Meadow Creek BLOCK / SECTION LOT 2 LOT AREA .64 acres SITE CLASS PS DESIGN FLOW 480 L.T.A.R. .135

Septic Tank: 1000 Gallons; STB 760 Date 4-23-99
Pump Tank: Gallons; PT Date
Pump Make: Model Serial No.
Nitrification Field: No Fields 1 Square Feet 1080 Linear Feet 360
No Lines 4 Trench Width 36" Max Trench Bottom Depth 36" Gravel Depth N/A

[✓] New System [ ] Repair System Type: I, II, III, IV, V, VI
System Description: Gravity Chamber or HPS
Repair System Description: 11 11 11
Maintenance Agreement Required: [ ] Yes [✓] No


[ ] House/Mod. Home No. Bedrooms 4
[✓] Mobile Home No. Bathrooms 2
[ ] Business No. Employees
[ ] Other
[ ] Slab [✓] Crawl Space [ ] Basement w/plumbing [ ] Basement wo/plumbing

Water Supply: [ ] Individual [✓] Public [ ] Community


Comments:/Conditions: Replaces permit Issued 10-20-97 To Peeks Inc.

Comments:/Conditions:

INITIAL SITE SKETCH

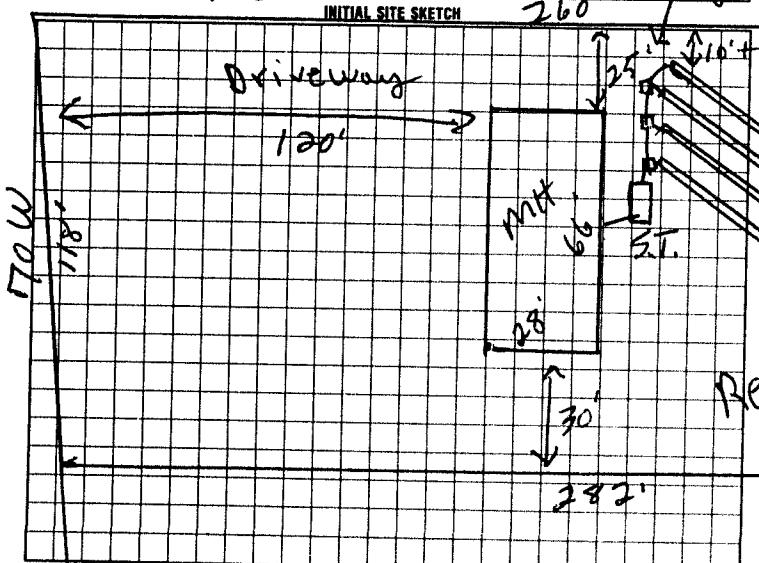

AS BUILT SKETCH

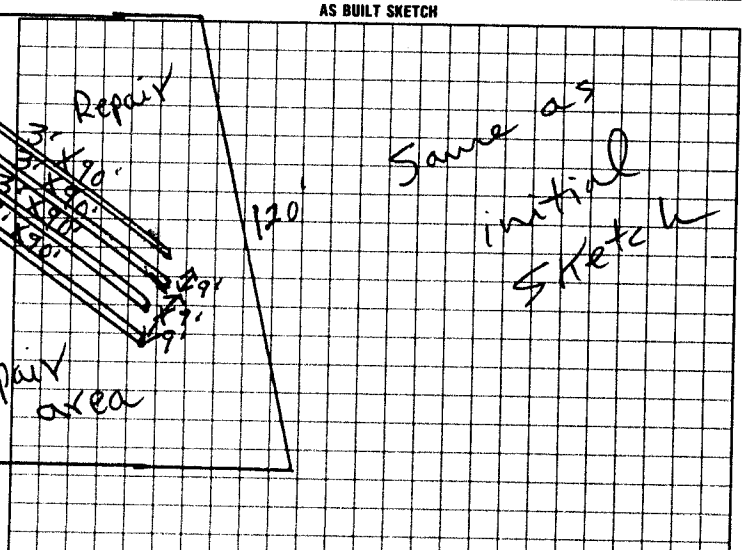

I understand that this permit can be suspended or revoked if any false information is supplied toward securing the permit/any unauthorized changes are made to the site/any unauthorized changes are made in the installation of the system. Improvement Permit with plat valid without expiration. Improvement Permit with site plan valid for sixty months. Authorization to Construct is valid for a period equal to that of Improvement Permit – not to exceed sixty months.

Signed: Tammy M. Scott date 5-15-98 Installed by: Billy Eckert Hickory S.T.

Improvement Permit by: F.C. Moore date 5-11-98 Operation Permit by: F.C. Moore date 6-9-99

Authorization to Construct by: F.C. Moore date 5-11-98 Existing System Inspection by: date

HEALTH DEPT. COPY WHITE INSPECTION COPY (FINAL) GREEN OWNER COPY (FINAL) YELLOW INSPECTION COPY (INITIAL) PINK OWNER COPY (INITIAL) GOLD