THIS PERMIT VOIDS PREVIOUS ISSUED 8-26-98

IREDELL COUNTY HEALTH DEPARTMENT

STATESVILLE 704-878-5305 MOORESVILLE 704-664-5281

IMPROVEMENT PERMIT / AUTHORIZATION TO CONSTRUCT / OPERATION PERMIT / EXISTING SYSTEM INSPECTION

PERMIT# 071387 PIN# 3792 26 8055 (PT) DATE 9-24-00

OWNER OR CONTRACTOR PEEKS INC PHONE: Business (704) 567-9836 Home

ADDRESS 5201 MONROE ROAD CHARLOTTE, NC

LOCATION US 70 WEST, TL HIDDEN BROOK, LOT # 10 ON RIGHT

SUBDIVISION MEADOW CREEK BLOCK / SECTION LOT 10 LOT AREA 0.64 ACRES SITE CLASS PS DESIGN FLOW 360 L.T.A.R. 0.30 GPD/FT2

Septic Tank: 1000 Gallons; STB 1012 Date 6-6-00
Pump Tank: Gallons; PT Date
Pump Make: Model Serial No.
Nitrification Field: No Fields 1 Square Feet 1200 Linear Feet 400
No Lines FIVE Trench Width 36" Max Trench Bottom Depth 30" Gravel Depth 12"

☐ New System ☐ Repair System Type: I, II, III, IV, V, VI
System Description: CONVENTIONAL GRAVITY
Repair System Description: 50% REDUCTION Pump
Maintenance Agreement Required: ☐ Yes ☐ NO


☐ House/Mod. Home No. Bedrooms 3
☑ Mobile Home No. Bathrooms 2
☐ Business No. Employees
☐ Other
☐ Slab ☑ Crawl Space ☐ Basement w/plumbing ☐ Basement wo/plumbing

Water Supply: ☐ Individual ☐ Public ☐ Community


Comments:/Conditions:

Comments:/Conditions:

INITIAL SITE SKETCH SCALE: 1" = 40'

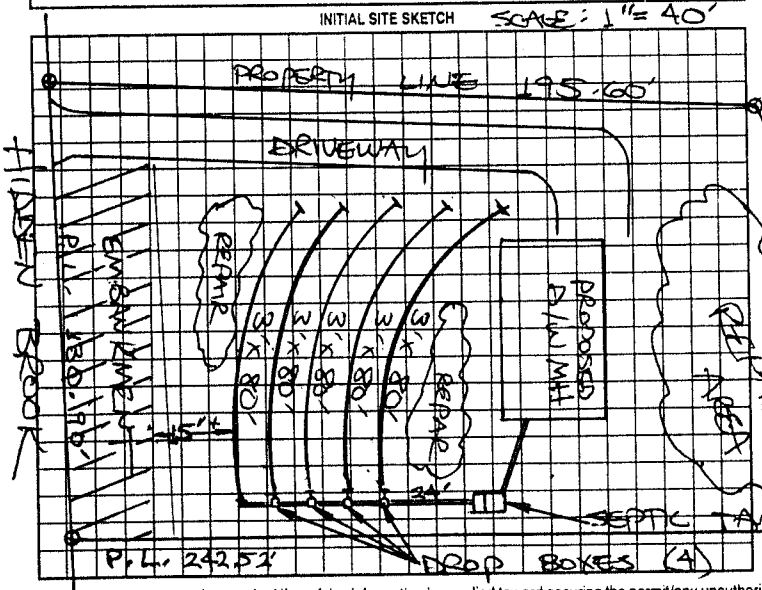

AS BUILT SKETCH

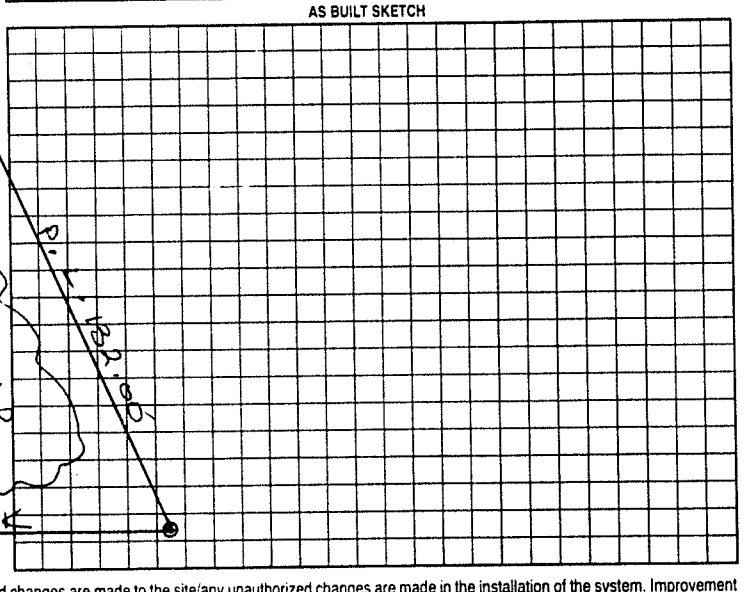

Permit can be suspended or revoked if any false information is supplied toward securing the permit/any unauthorized changes are made to the site/any unauthorized changes are made in the installation of the system. Improvement Permit with plat valid without expiration. Improvement Permit with site plan valid for sixty months. Authorization to Construct is valid for a period equal to that of Improvement Permit – not to exceed sixty months.

Signed: Dennis Gallihen date 8-25-00 Installed by: A-1 Backhoe

Improvement Permit by: STEVE HEDRICK date 8-24-00 Operation Permit by: RSI date 9/1/00

Authorization to Construct by: STEVE HEDRICK date 8-24-00 Existing System Inspection by: date

HEALTH DEPT. COPY: WHITE OWNER COPY (FINAL): YELLOW OWNER COPY (INITIAL): PINK