IREDELL COUNTY HEALTH DEPARTMENT

STATESVILLE 704-878-5305 MOORESVILLE 704-664-5281

IMPROVEMENT PERMIT / AUTHORIZATION TO CONSTRUCT / OPERATION PERMIT / EXISTING SYSTEM INSPECTION

PERMIT# 07|386 PIN# 3792 26 5655 (PT) DATE 8/26/98

OWNER OR CONTRACTOR Peeks Inc PHONE: Business (704) 561-9536 Home

ADDRESS 5201 Monroe Rd Charlotte, NC 28205

LOCATION Hwy 70 W to Hidden Brook (B4 Wayforest) on Right

SUBDIVISION Meadowview I BLOCK / SECTION II LOT 9 LOT AREA .74 Acre SITE CLASS. PSJ DESIGN FLOW 360gpd L.T.A.R. 3

Septic Tank: 1000 Gallons; STB Date

Pump Tank: Gallons; PT Date

Pump Make: Model Serial No.

Nitrification Field: No Fields 1 Square Feet 1260 Linear Feet 900

No Lines 3@133' Trench Width 36" Max Trench Bottom Depth 18" Gravel Depth 12"

☒ New System ☐ Repair System Type: I, II, III, IV, V, VI

System Description: Gravity - Conventional

Repair System Description: Septic (Pump/Gravity)

Maintenance Agreement Required: ☐ Yes ☒ No

☐ House/Mod. Home ☒ Mobile Home ☐ Business ☐ Other

No. Bedrooms 3 No. Bathrooms 2 No. Employees


☐ Slab ☒ Crawl Space ☐ Basement w/plumbing ☐ Basement wo/plumbing

Water Supply: ☐ Individual ☒ Public ☐ Community


Comments:/Conditions: Keep Septic System 5' from House & 10' from PL

Comments:/Conditions: 6 Lines Total 400' 1200 sq' 242'

INITIAL SITE SKETCH Scale 1:50

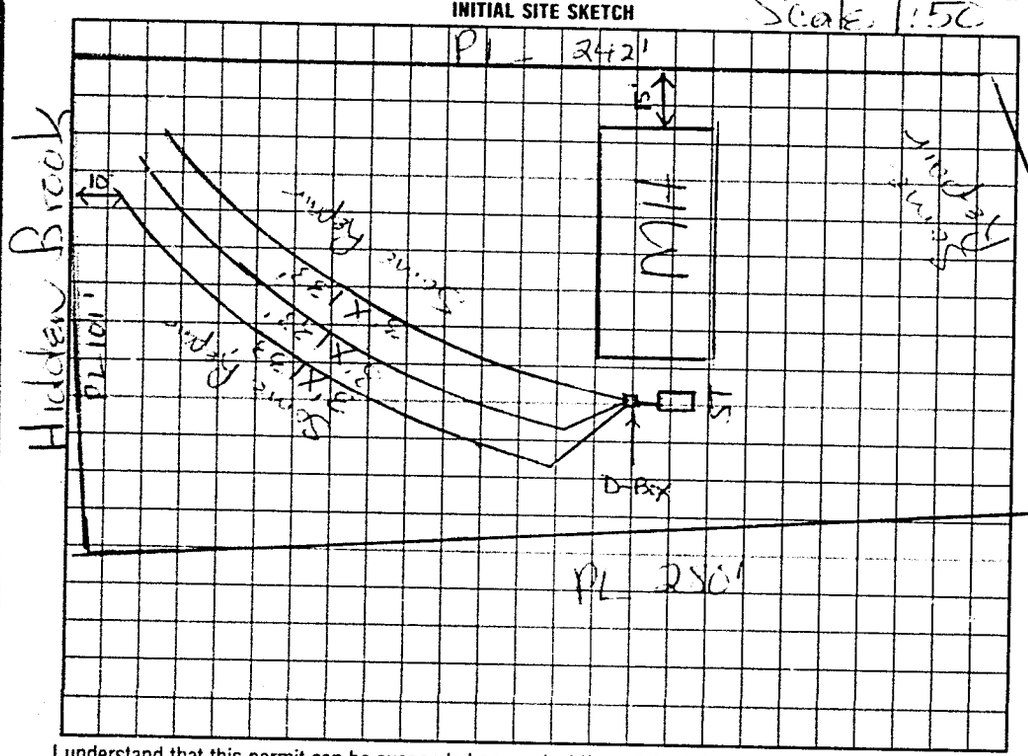

AS BUILT SKETCH

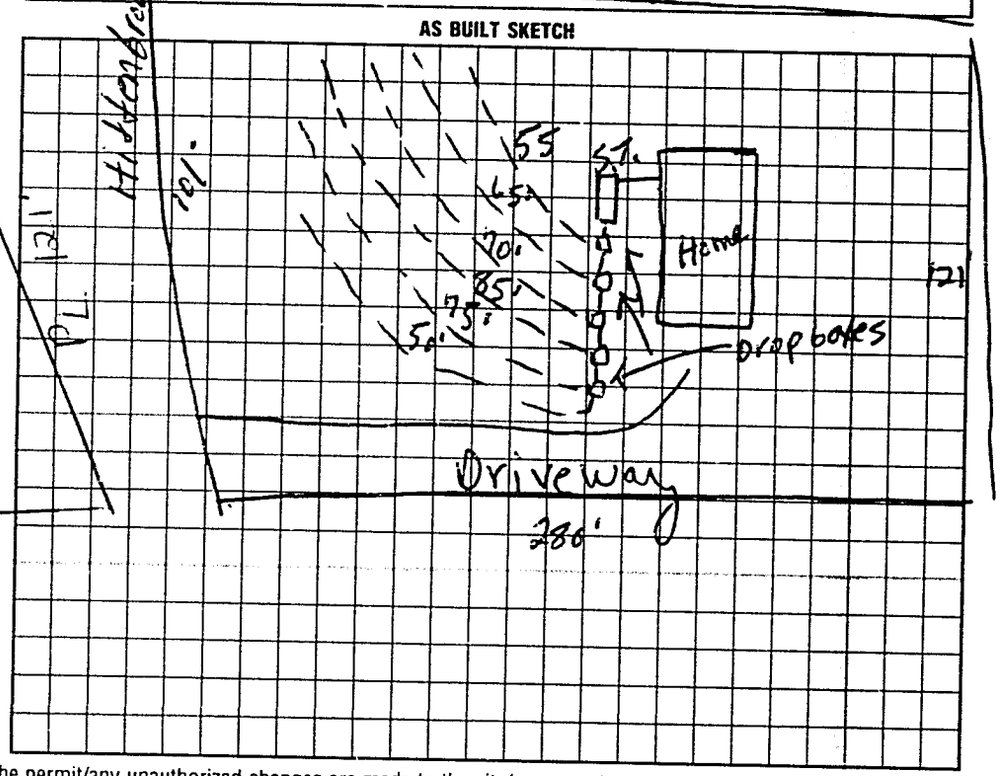

I understand that this permit can be suspended or revoked if any false information is supplied toward securing the permit/any unauthorized changes are made to the site/any unauthorized changes are made in the installation of the system. Improvement Permit with plat valid without expiration. Improvement Permit with site plan valid for sixty months. Authorization to Construct is valid for a period equal to that of Improvement Permit – not to exceed sixty months.

Signed: Jeff Casey agent date 9/18/98

Improvement Permit by: Melissa H. Eaton date 8/26/98

Authorization to Construct by: P.C. Moore date 11-6-98

Installed by: A-1 Backhoe

Operation Permit by: P.C. Moore date 11-6-98

Existing System Inspection by: date

HEALTH DEPT COPY WHITE INSPECTION COPY (FINAL) GREEN OWNER COPY (FINAL) YELLOW INSPECTION COPY (INITIAL) PINK OWNER COPY (INITIAL) GOLD