# IREDELL COUNTY HEALTH DEPARTMENT

STATESVILLE 704-878-5305 MOORESVILLE 704-664-5281

## IMPROVEMENT PERMIT / AUTHORIZATION TO CONSTRUCT / OPERATION PERMIT / EXISTING SYSTEM INSPECTION

PERMIT# 071383 PIN# 3792 26 8055 (PT) DATE 7/31/98

OWNER OR CONTRACTOR Peeks, Inc. PHONE: Business (704) 561-98-36 Home

ADDRESS 5201 Monroe Rd Charlotte, NC 28205

LOCATION Hwy 70 W to L on Hidden Brook (Bt Windcrest) on Right

SUBDIVISION Meadow Creek BLOCK / SECTION 2 LOT 8 LOT AREA 1.01 Acre SITE CLASS. P3 DESIGN FLOW 360 gpd L.T.A.R. .3

Septic Tank: 1000 Gallons; STB 1012 Date 12-10-99
Pump Tank: ____ Gallons; PT ____ Date ____
Pump Make: ____ Model ____ Serial No. ____
Nitrification Field: No Fields 1 Square Feet 1200' Linear Feet 400
No Lines 5 at 80' Trench Width 36" Max Trench Bottom Depth 36"

☐ New System ☐ Repair System Type: I (II) III, IV, V, VI
System Description: Gravity - Conventional
Repair System Description: Same
Maintenance Agreement Required: ☐ Yes ☒ No

☐ House/Mod. Home No. Bedrooms 3
☒ Mobile Home No. Bathrooms 2
☐ Business No. Employees ____
☐ Other ____


Gravel Depth 12" ☐ Slab ☒ Crawl Space ☐ Basement w/plumbing ☐ Basement wo/plumbing

Water Supply: ☐ Individual ☒ Public ☐ Community


Comments:/Conditions: Keep Septic System at least 5' from House & 10' from PL. Divert Storm water away from Septic Area(s).

Comments:/Conditions: 3-14-2000 Due to drain location to 666 ft Lines to be installed

**INITIAL SITE SKETCH** Scale 1:50

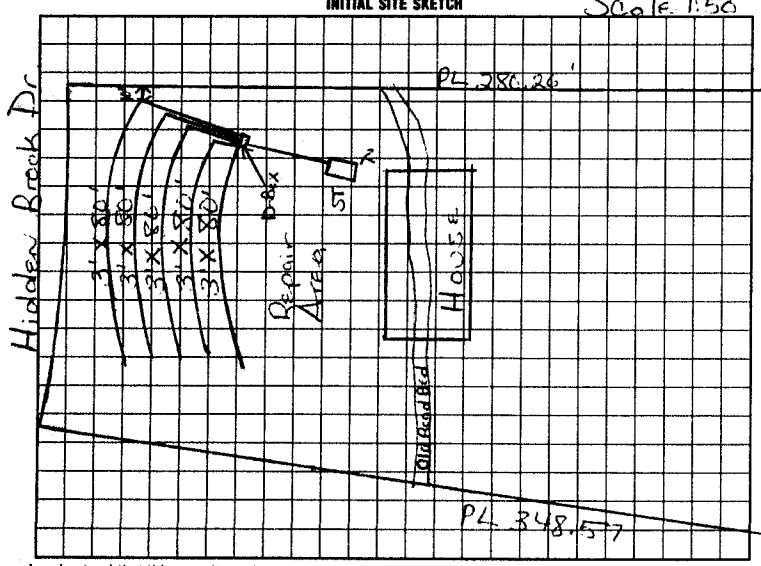


**AS BUILT SKETCH**

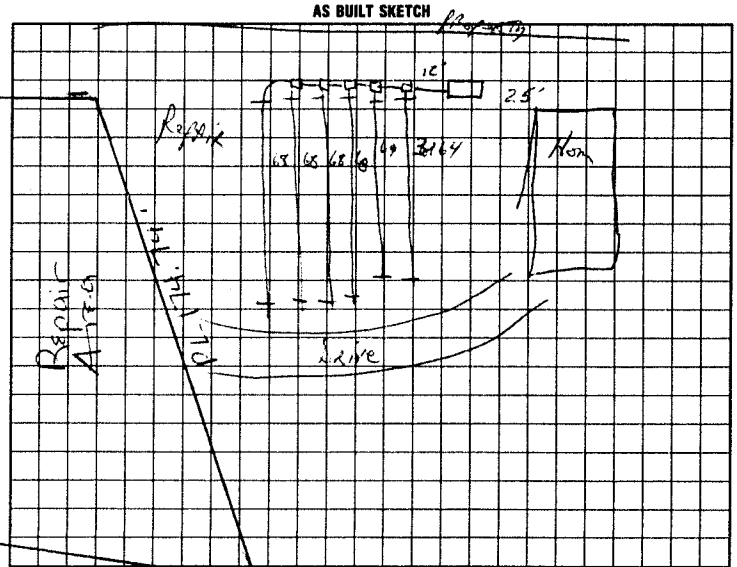


I understand that this permit can be suspended or revoked if any false information is supplied toward securing the permit/any unauthorized changes are made to the site/any unauthorized changes are made in the installation of the system. Improvement Permit with plat valid without expiration. Improvement Permit with site plan valid for sixty months. Authorization to Construct is valid for a period equal to that of Improvement Permit – not to exceed sixty months.

Signed: M Casey agent date 9/18/98 Installed by: Al Backhoe

Improvement Permit by: Marie H. Dobson date 7/31/98 Operation Permit by: [illegible] date March 15-2000

Authorization to Construct by: D.C. Moore date 1-07-00 Existing System Inspection by: ____ date ____

HEALTH DEPT. COPY: WHITE INSPECTION COPY (FINAL): GREEN OWNER COPY (FINAL): YELLOW INSPECTION COPY (INITIAL): PINK OWNER COPY (INITIAL): GOLD