IREDELL COUNTY HEALTH DEPARTMENT

STATESVILLE 704-878-5305 MOORESVILLE 704-664-5281

IMPROVEMENT PERMIT / CERTIFICATE OF COMPLETION / OPERATION PERMIT / EXISTING SYSTEM INSPECTION

PROPERTY DESCRIPTION NO. 6687 DATE June 10, '97 TAX MAP NO. 4703061916 Watershed: ☑ Yes ☐ No

OWNER OR CONTRACTOR Roger Boast PHONE: Business Home

ADDRESS 114 Woodlawn Dr. Statesville WATAUGA

LOCATION Buffalo Shoals Rd S. to Old Mtn Rd to Beulah Bean left on Mocksville Rd past @ Stewart Ave.

SUBDIVISION Stewart Acres BLOCK / SECTION LOT 25 LOT AREA 1.0 Ac SITE CLASS 15 DESIGN FLOW 360gpd L.T.A.R. 2 at rate

Septic Tank: 1000 Gallons; STB 824 Date 8-21-97

Pump Tank: Gallons; PT Date

Pump Make: Model Serial No.

Nitrification Field: No Fields 1 Square Feet 1200 Linear Feet 400

No Lines 5@80' Trench Width 36" Max Trench Bottom Depth 36"

☑ New System ☐ Repair System Type: I II III IV V VI

System Description: gravity conventional

Repair System Description: Stallion new conv.

Maintenance Agreement Required: ☐ Yes ☑ No

Gravel Depth 12" ☐ Slab ☑ Crawl Space ☐ Basement w/plumbing ☐ Basement wo/plumbing

☑ House/Mod. Home No. Bedrooms 3

☐ Mobile Home No. Bathrooms 2

☐ Business No. Employees

☐ Other


Water Supply: ☐ Individual ☐ Community ☑ Public

Comments: Exact plumbing at existing grade where shown Remove/Shave off Old Farm Bldg remnant


Comments:

1"=60'

INITIAL SITE SKETCH

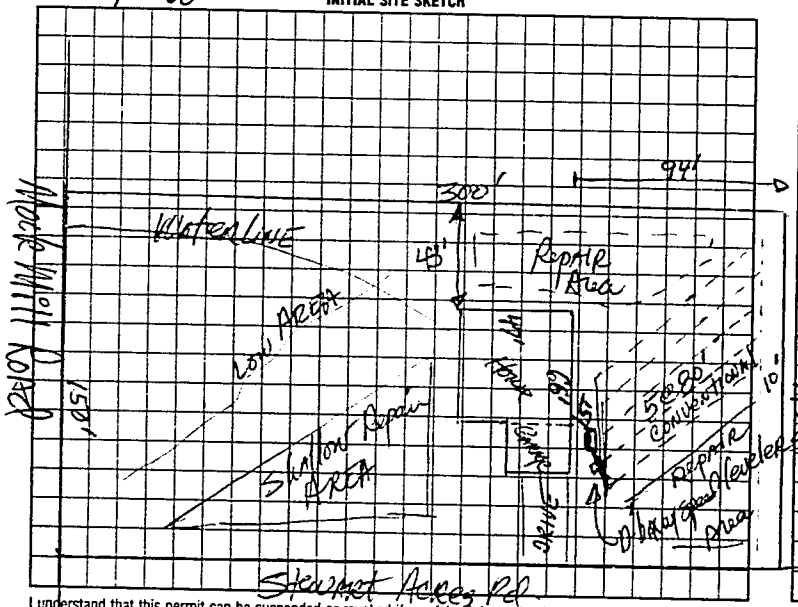

AS BUILT SKETCH

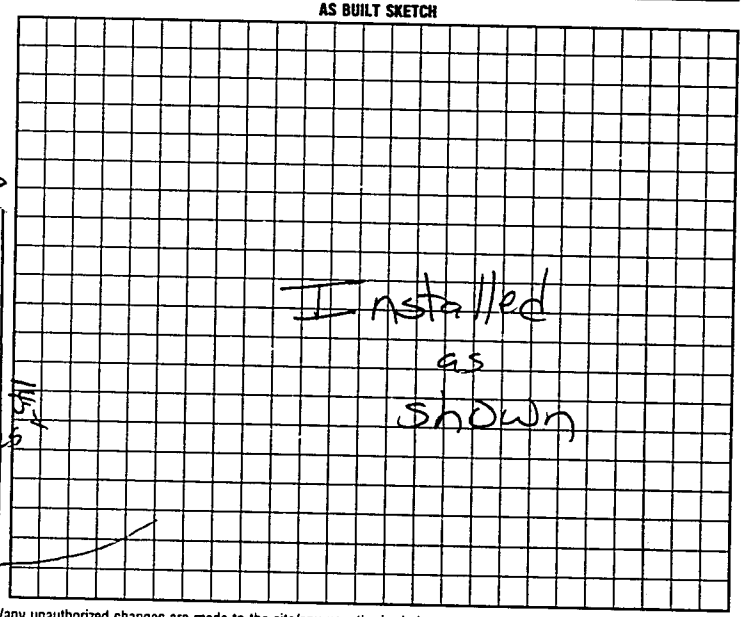

I understand that this permit can be suspended or revoked if any false information is supplied toward securing the permit/any unauthorized changes are made to the site/any unauthorized changes are made in the installation of the system. Improvement Permit is valid for 60 months from date of issuance.

Signed: [signature]

Improvement Permit by: [signature] date 6-10-97

~~Final System Inspection by:~~ Construction Authorization by: [signature] date 6-10-97

Installed by: D+D Grading

Certificate of Completion by:

Operation Permit by: [signature] date 9-23-97

IMPROVEMENT PERMIT COPY WHITE INSPECTION COPY (FINAL) GREEN OWNER COPY (FINAL) YELLOW INSPECTION COPY (INITIAL) PINK OWNER COPY (INITIAL) GOLD