OD 9 25 12 1297

IREDELL COUNTY HEALTH DEPARTMENT

STATESVILLE 704-878-5305 MOORESVILLE 704-664-5281

IMPROVEMENT PERMIT / CERTIFICATE OF COMPLETION / OPERATION PERMIT / EXISTING SYSTEM INSPECTION

PROPERTY DESCRIPTION NO. 10689 DATE 12-10-97 TAX MAP NO. 4703 07 4006 Watershed: ☑ Yes ☐ No

OWNER OR CONTRACTOR John M Wallace PHONE: Business 704 294 1937 Home WSIV CA

ADDRESS 136 Courtney Ct. Hickory N/C

LOCATION Old Mtn Rd Turn Mock Mill Rd past Shady Rest Rd 1st lot Rt

SUBDIVISION Stewart Acres BLOCK / SECTION ____ LOT 2 LOT AREA 1.65 acres SITE CLASS. 05 DESIGN FLOW 360 L.T.A.R. .25

Septic Tank: 1000 Gallons; STB 10.2 Date 5-23-97
Pump Tank: ____ Gallons; PT ____ Date ____
Pump Make: ____ Model ____ Serial No. ____
Nitrification Field: No Fields 1 Square Feet 1080 Linear Feet 360
No Lines 5 Trench Width 36" Max Trench Bottom Depth 24" Gravel Depth N/A

☑ New System ☐ Repair System Type: I, II, III, IV, V, VI
System Description: Gravity chambers
Repair System Description: Pump To chamber
Maintenance Agreement Required: ☐ Yes ☑ No
☐ Slab ☐ Crawl Space ☐ Basement w/plumbing ☐ Basement wo/plumbing


☑ House/Mod. Home No. Bedrooms 3
☐ Mobile Home No. Bathrooms 2
☐ Business No. Employees ____
☐ Other ____

Water Supply:
☐ Individual
☐ Community
☑ Public


Comments:

Comments:

INITIAL SITE SKETCH

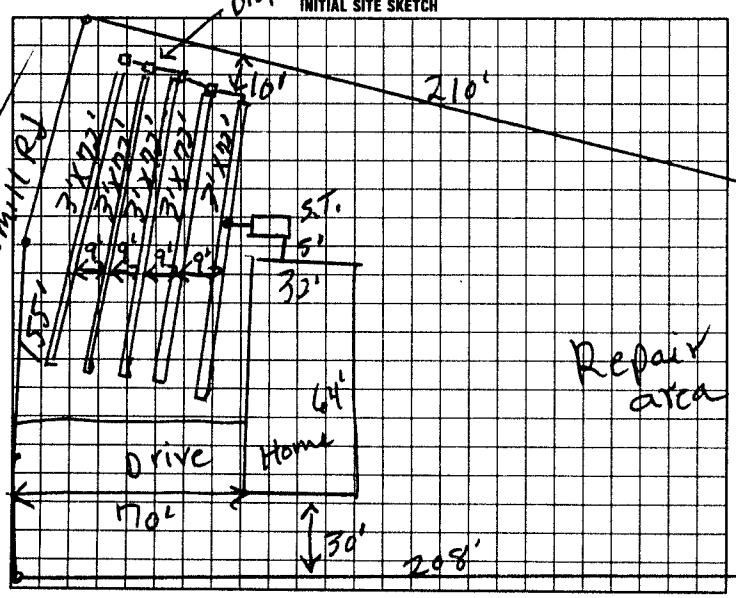

AS BUILT SKETCH

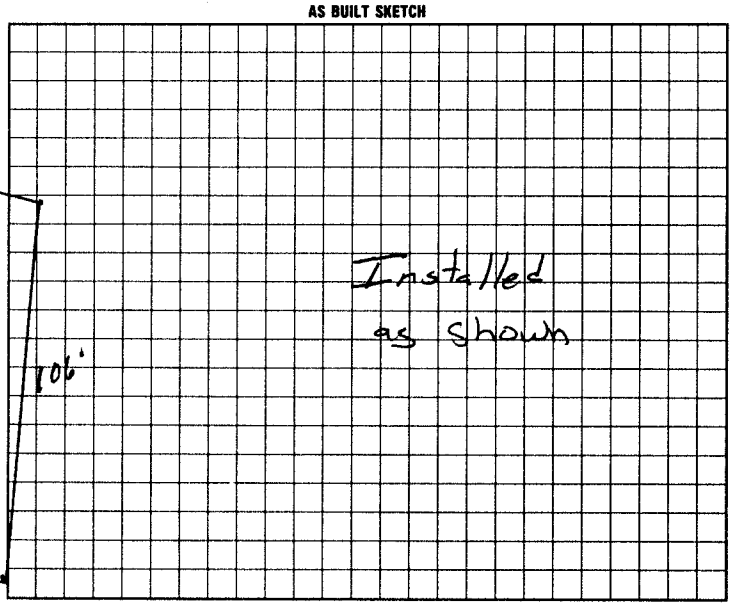

I understand that this permit can be suspended or revoked if any false information is supplied toward securing the permit/any unauthorized changes are made to the site/any unauthorized changes are made in the installation of the system. Improvement Permit is valid for 60 months from date of issuance.

Signed: John M. Wallace

Improvement Permit by: L.C. Moore date 12-10-97

~~Authorization~~ Existing System Inspection by: L.C. Moore date 12-10-97

Installed by: Craig Thompson

~~Certificate of Completion by:~~ ____ date ____

Operation Permit by: Mark C Ott RS date 7-14-97

HEALTH DEPT. COPY: WHITE INSPECTION COPY (FINAL): GREEN OWNER COPY (FINAL): YELLOW INSPECTION COPY (INITIAL): PINK OWNER COPY (INITIAL): GOLD

to Const. Authorization to Const Expires 60 mos from issue